


# marathon county surveyor

## SECTION SUMMARY

35 - 39 - 6  
Section    Town    Range

BRADLEY  
Township

U.P.-17,21

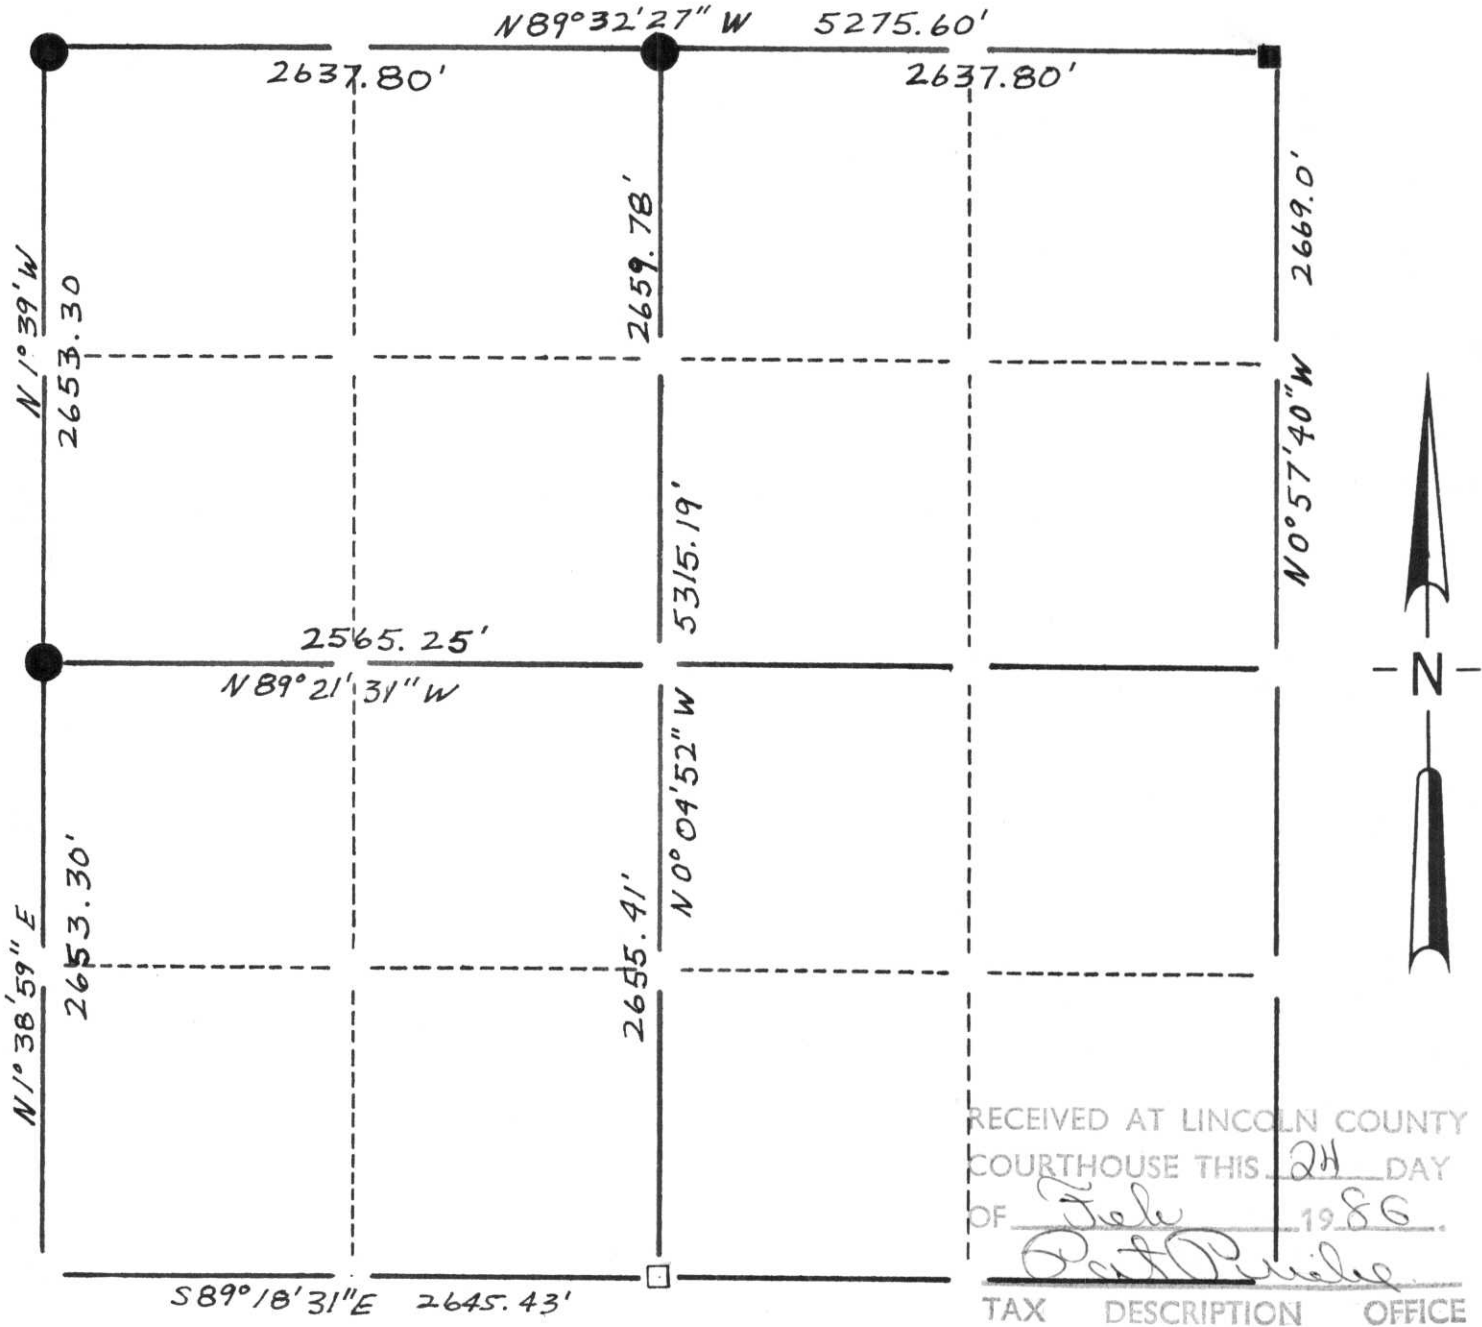

### LEGEND

- Harrison Cast Iron Monument
- Stone or Concrete Monument
- 2" Iron Pipe
- 1" Iron Pipe
- Iron Bar

- RR Spike
- PK Nail
- Other - Berntsen Monument
- 
-