




SECTION SUMMARY

36 - 34N - 6E
Section Township Range
BRADLEY
Town

RECEIVED AT LINCOLN COUNTY
COURTHOUSE THIS 9th DAY
OF January 20 02
Tommy Walker
LAND INFORMATION OFFICE

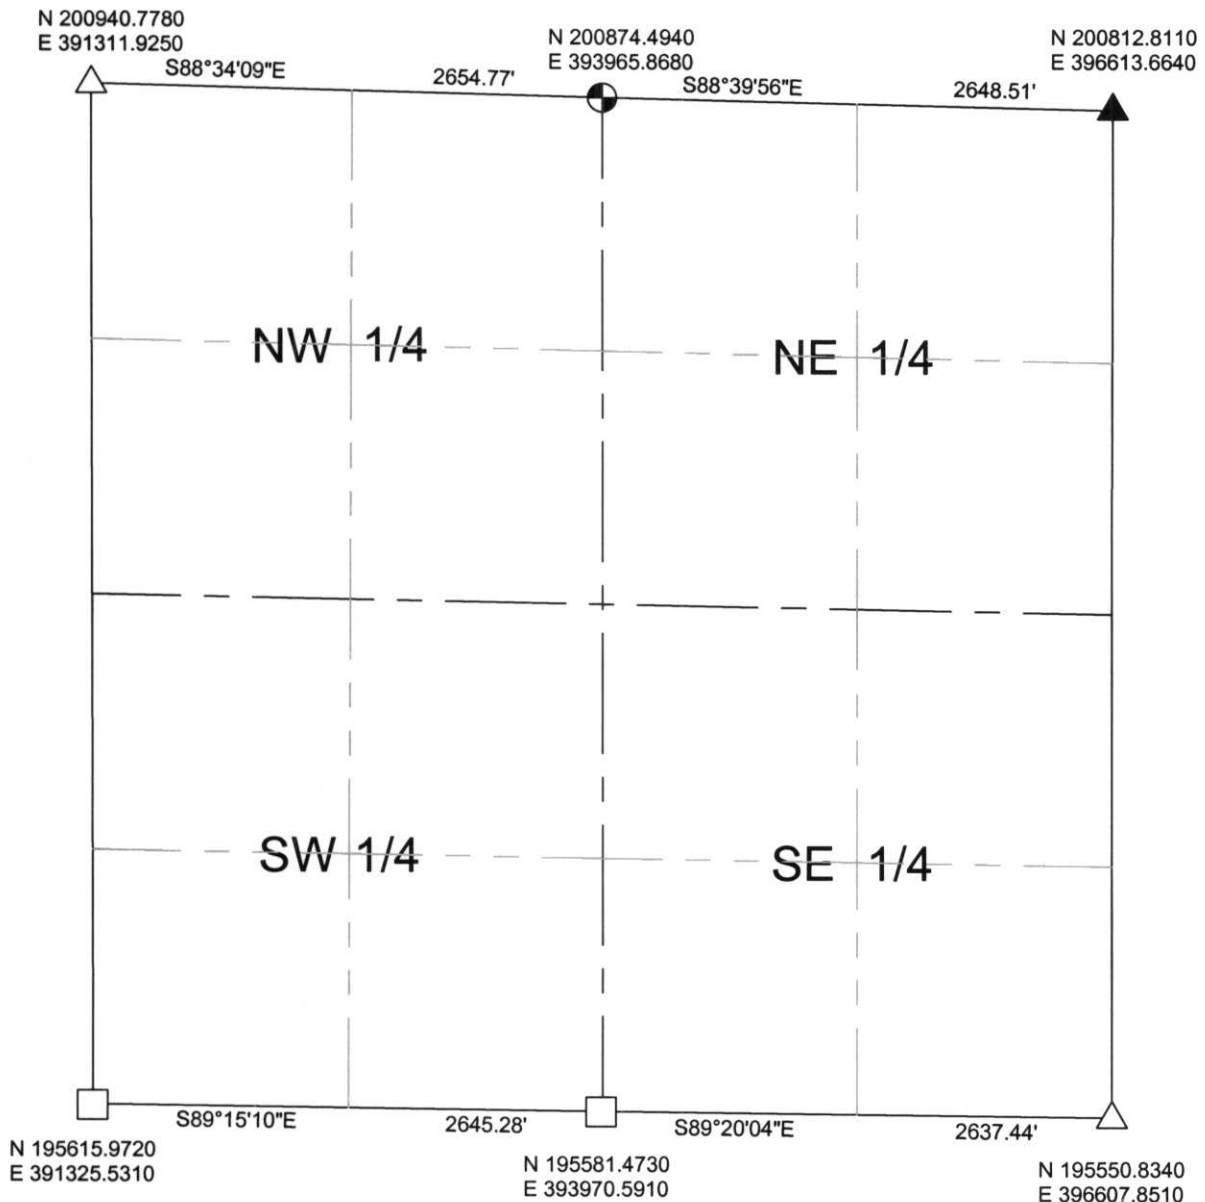

NOTES:
COORDINATES AND BEARINGS ARE REFERENCED TO THE LINCOLN COUNTY COORDINATE SYSTEM AS DEVELOPED BY THE WISCONSIN DEPARTMENT OF TRANSPORTATION AND WERE DETERMINED BY GPS OBSERVATIONS ON CONTROL POINTS AS SUPPLIED BY THE DOT.

LEGEND

- ⊕ - Lincoln County Monument
- - Stone Monument
- - 1-1/2" Iron Pipe
- - 2" Iron Pipe
- △ - PK Nail
- ▲ - Spike



CERTIFIED CORRECT:

Thomas A. Radenz
Registered Land Surveyor

DATE: 1/8/02

WV: 21, 25




36 - 34 - 6
Section Town Range

BRADLEY (SOUTH)
Township

SECTION SUMMARY

N

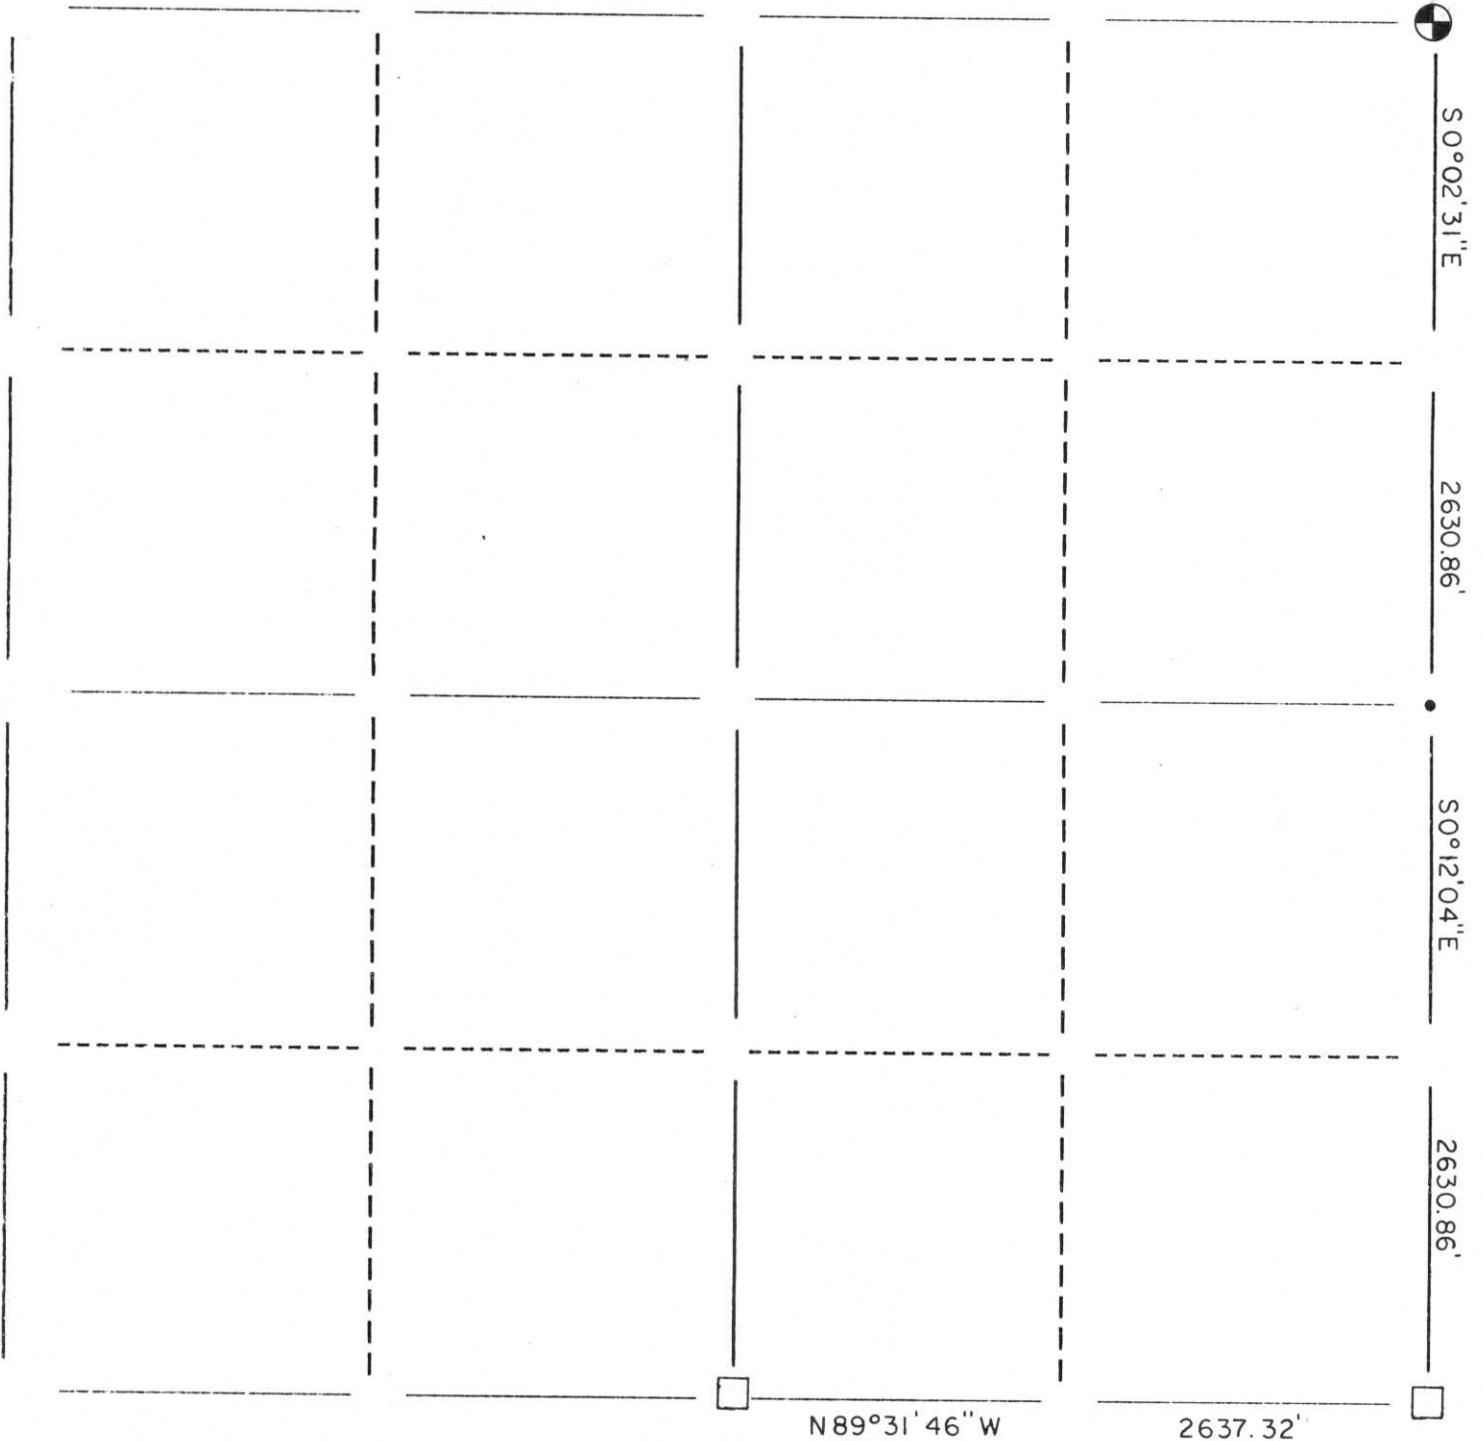

LEGEND

- Berntsen Monument
- 2" Iron Pipe
- Stone or Concrete Monument
- 1" Iron Pipe
- Iron Pipe
- Other (NAIL)

RECEIVED AT LINCOLN COUNTY
 COURTHOUSE THIS 7th DAY
 OF Oct 19 98
Pat Priebe
 TAX DESCRIPTION OFFICE



CERTIFIED CORRECT
Edwin R. Abendroth
S-798
 Registered Land Surveyor

DATE: Oct. 6, 1998

U.V. - 21,25