



T. 34N. R. 7E.

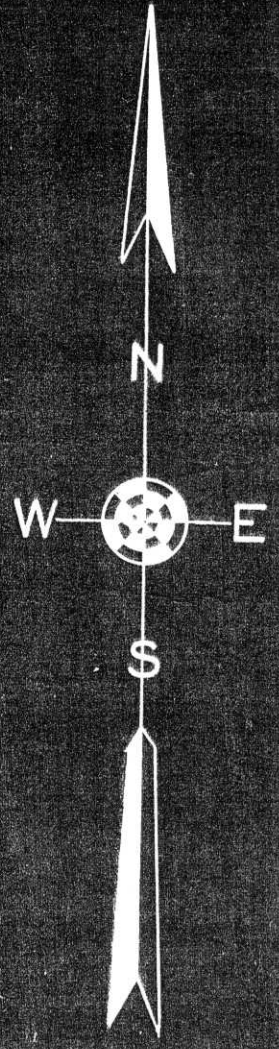

Surveyed 1937 Drawn 1938
For Lincoln Co. & Wisconsin
Conservation Comms.
By Francis X. Fuchs
Scale 4" = 1 Mile Ave. Var = 2° 30'

A-E: 21-25

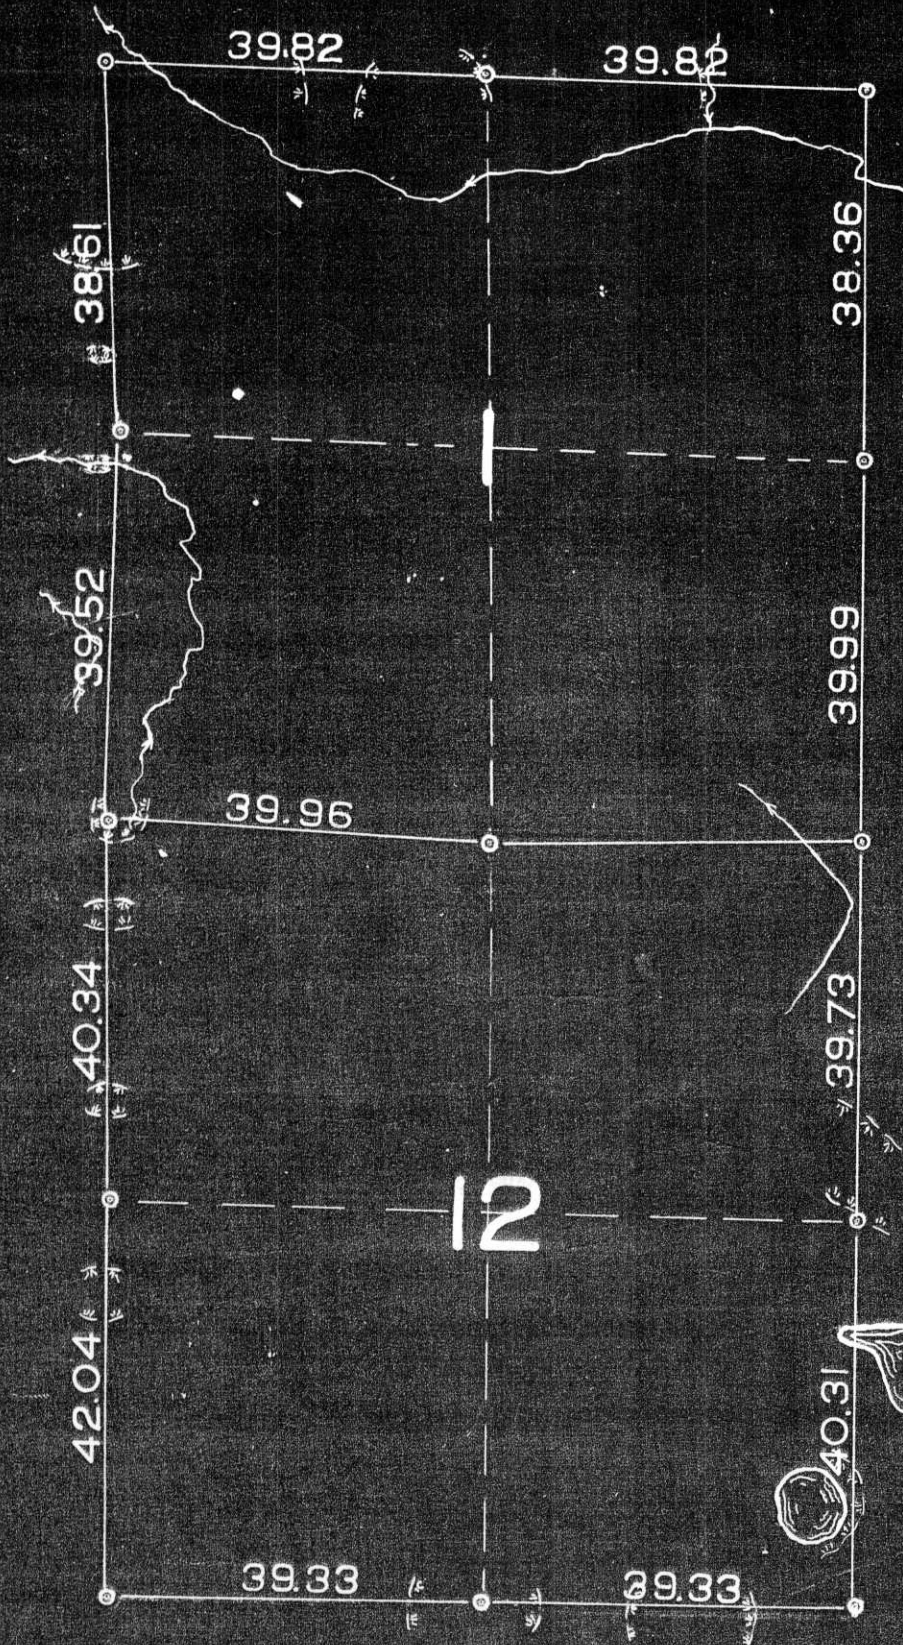


SECTION SUMMARY

1 - 34 - 7
 Section Township Range
 SKANAWAN
 Town

N 227039.2340
 E 423087.3550

N 227027.0740
 E 425832.2970

N 227014.3010
 E 428479.4280

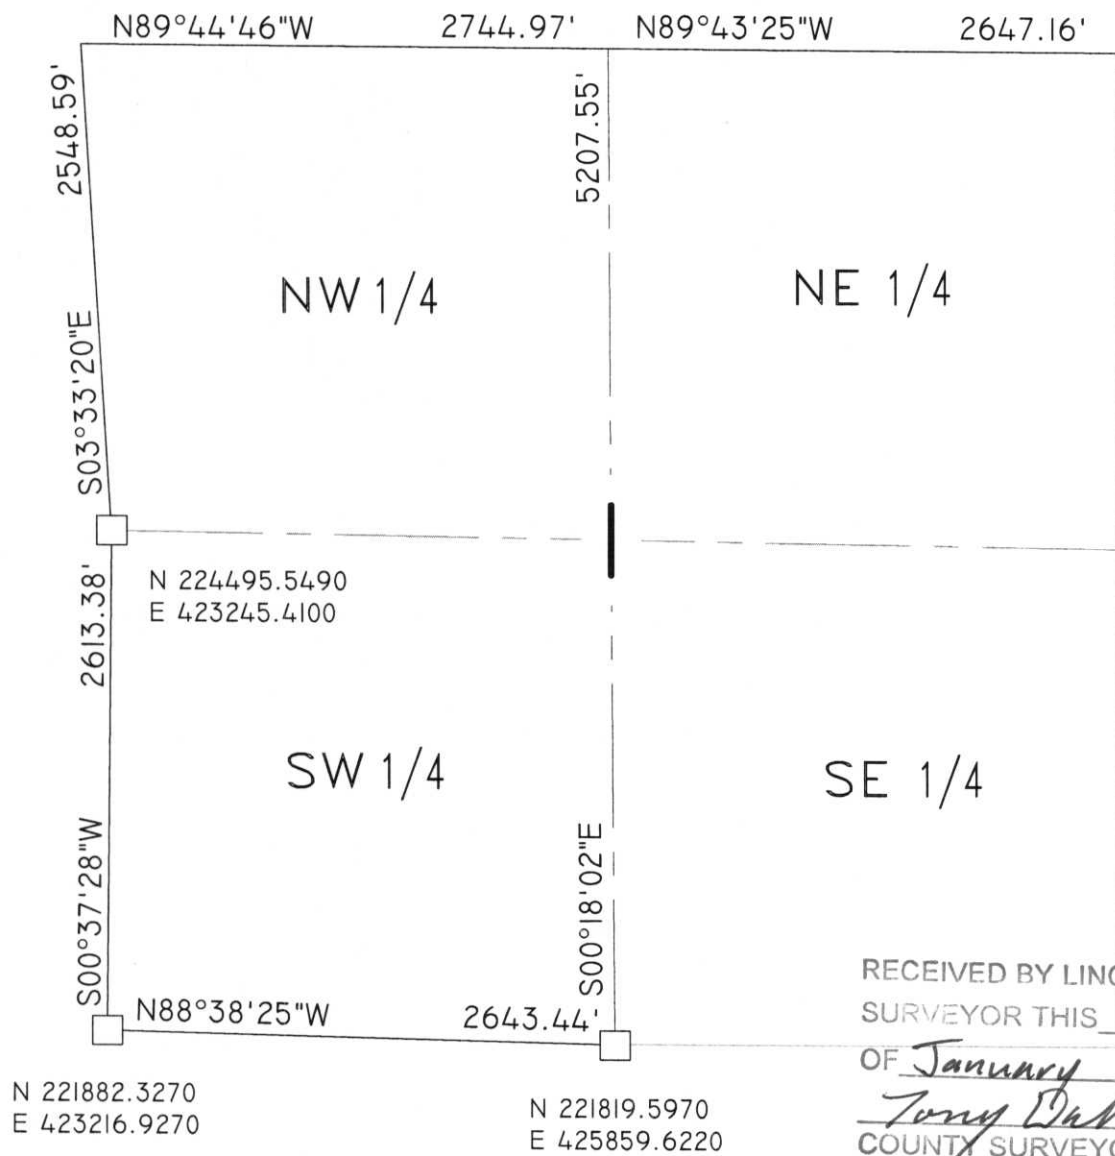


RECEIVED BY LINCOLN COUNTY
 SURVEYOR THIS 6TH DAY
 OF January 20 06
Tony Dahl
 COUNTY SURVEYOR

COORDINATES ARE REFERENCED TO THE LINCOLN COUNTY COORDINATE SYSTEM AS DEVELOPED BY THE WISCONSIN DEPARTMENT OF TRANSPORTATION AND ARE BASED ON GPS OBSERVATIONS TO CONTROL POINTS AS SUPPLIED BY LINCOLN COUNTY.

LEGEND

- - Lincoln County Monument (Berntsen)
- - Stone Monument
- - 1" Iron Pipe
- - 1" Iron Bar
- △ - Mag Nail

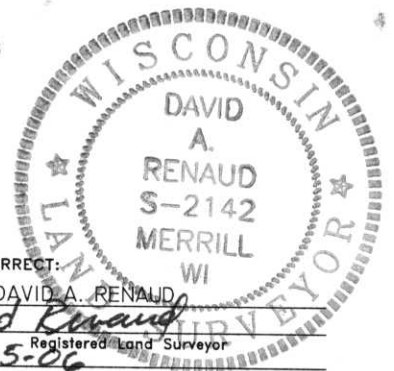

CERTIFIED CORRECT:
 DAVID A. RENAUD
David Renaud
 Registered Land Surveyor
 DATE: 1-5-06

R.E.I. 4080 N. 20th AVE WAUSAU, WI 54401 (715)675-9784

A-E: 21-25