




SECTION SUMMARY
 8 - 34 - 7
 Section Township Range
 SKANAWAN
 Town

N 221969.1870
 E 402126.6150

N 221955.9200
 E 404680.4254

N 221942.1890
 E 407323.5450

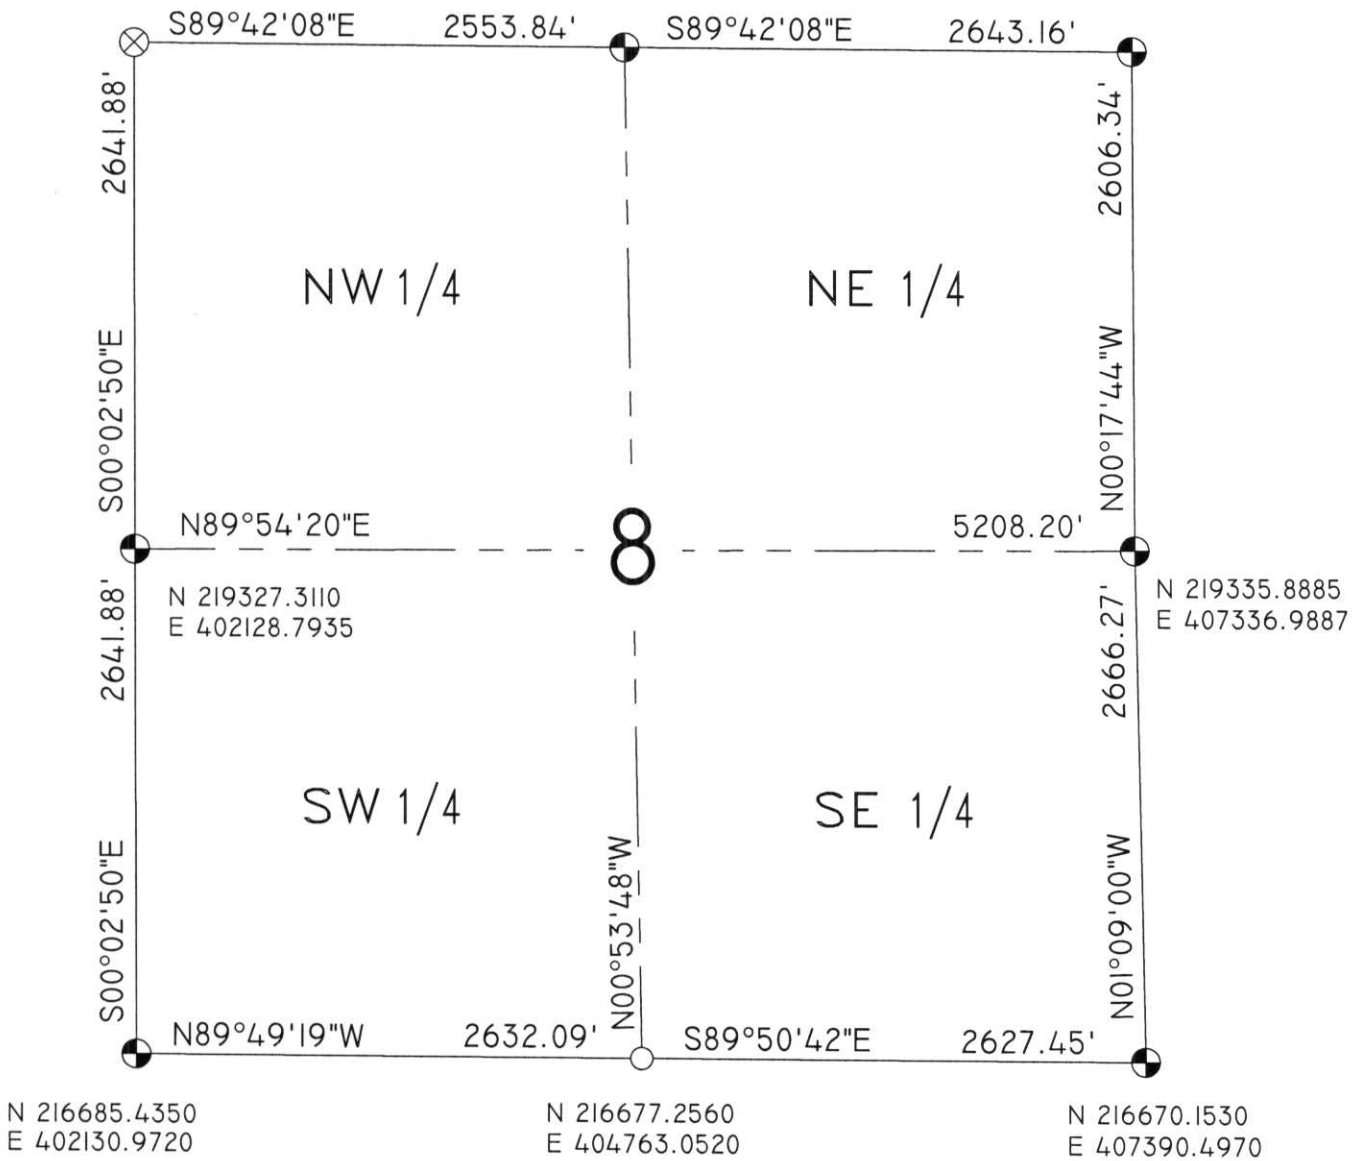

COORDINATES ARE REFERENCED TO THE LINCOLN COUNTY COORDINATE SYSTEM AS DEVELOPED BY THE WISCONSIN DEPARTMENT OF TRANSPORTATION AND ARE BASED ON GPS OBSERVATIONS TO CONTROL POINTS AS SUPPLIED BY LINCOLN COUNTY.

LEGEND

- ⊙ - Lincoln County Monument (Berntsen)
- - Stone Monument
- - 1-1/2" Capped Iron Pipe
- ▲ - PK Nail
- △ - Mag Nail
- ⊗ - 2" Iron Pipe

RECEIVED BY LINCOLN COUNTY

SURVEYOR THIS 6TH DAY

OF January 20 06

Tony Walker
 COUNTY SURVEYOR


R.E.I. 4080 N. 20th AVE WAUSAU, WI 54401 (715)675-9784

CERTIFIED CORRECT:

DAVID A. RENAUD

Registered Land Surveyor

DATE: 1-06-06

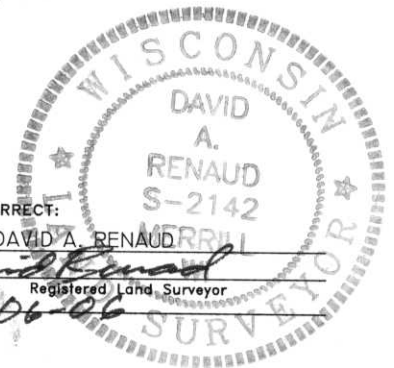

E-I: 5-9