


T.34N. R.7E.



Surveyed 1937 Drawn 1938
For Lincoln Co. & Wisconsin
Conservation Comms.
By Francis X. Fuchs
Scale 4" = 1 Mile Ave. Var = 2° 30'

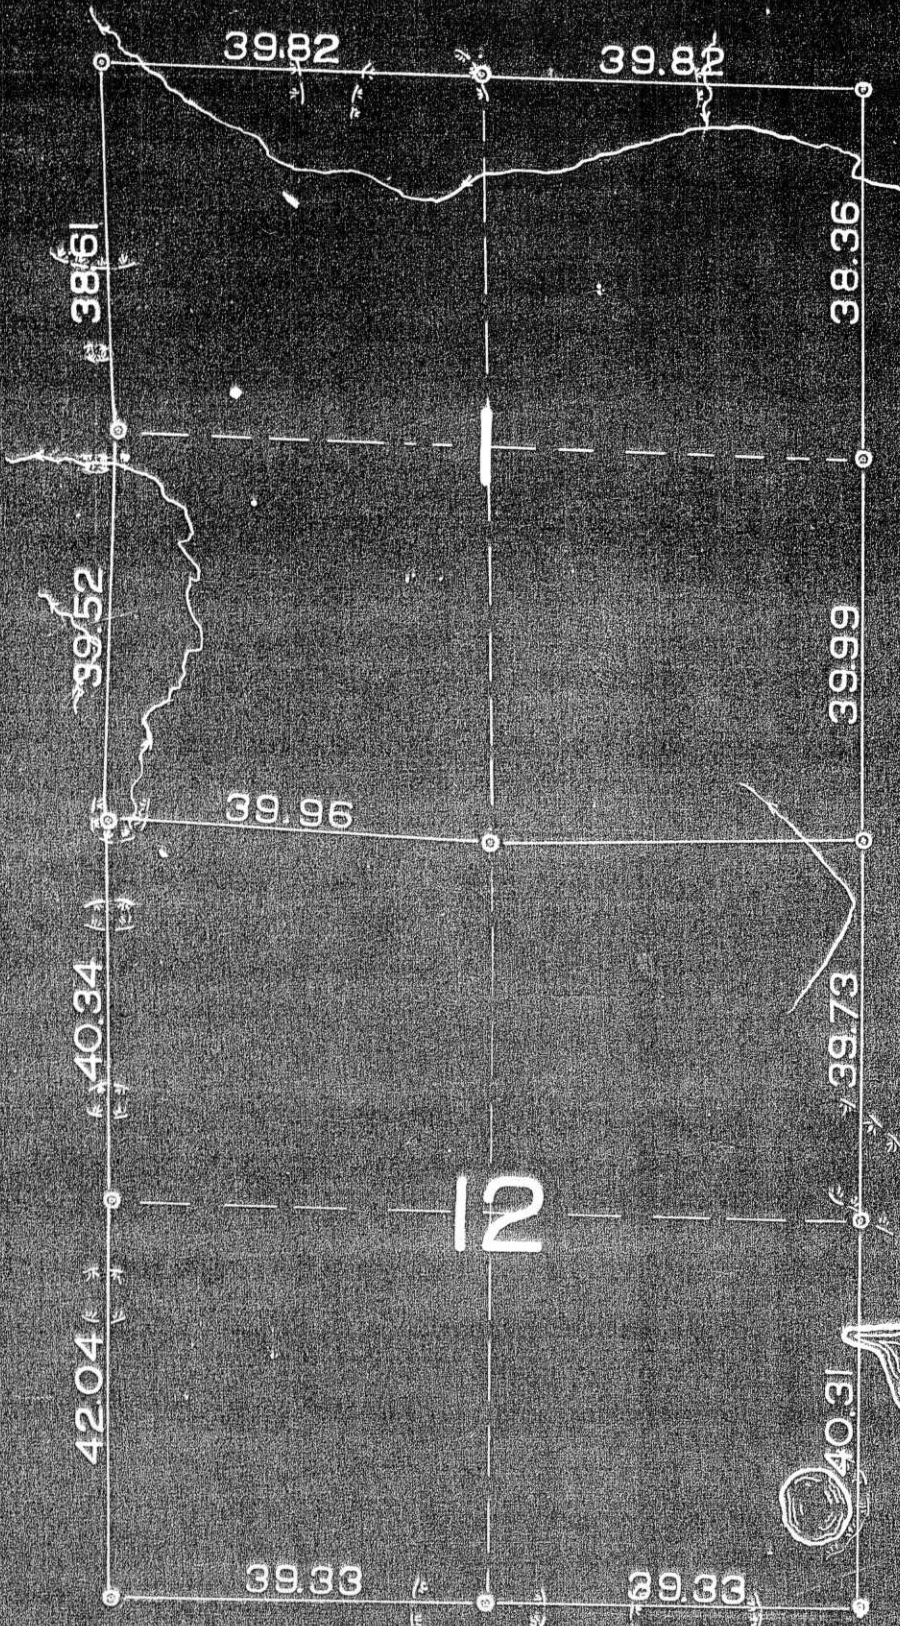


SECTION SUMMARY

12	-	34	-	7
Section		Township		Range
SKANAWAN				
Town				

N 221882.3270
E 423216.9270

N 221819.5970
E 425859.6220

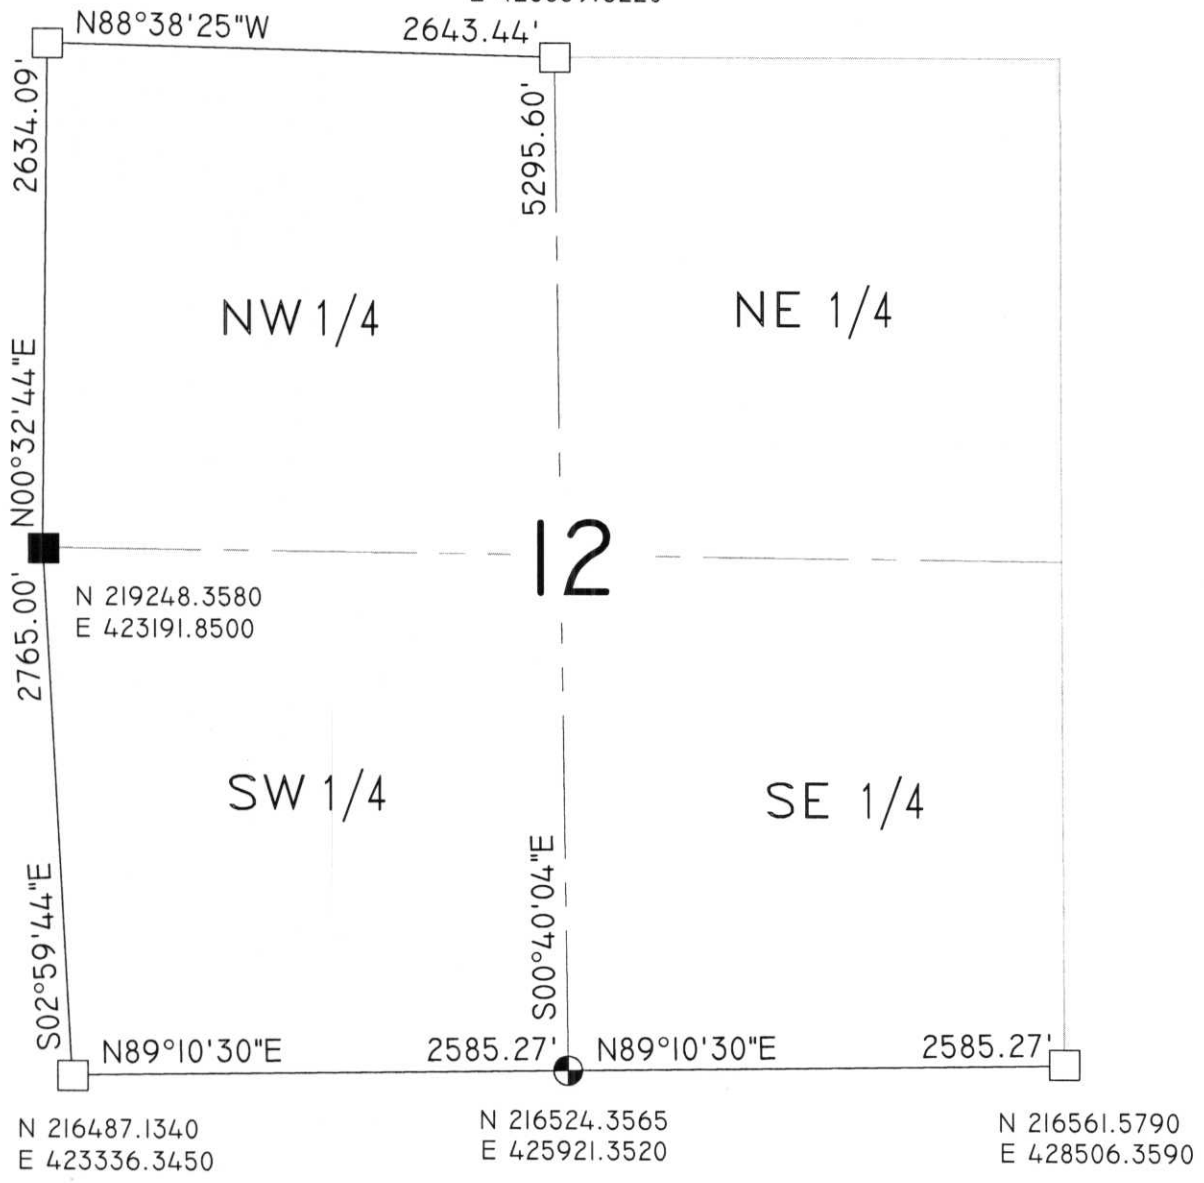

COORDINATES ARE REFERENCED TO THE LINCOLN COUNTY COORDINATE SYSTEM AS DEVELOPED BY THE WISCONSIN DEPARTMENT OF TRANSPORTATION AND ARE BASED ON GPS OBSERVATIONS TO CONTROL POINTS AS SUPPLIED BY LINCOLN COUNTY.


- LEGEND**
- - Lincoln County Monument (Berntsen)
 - - Stone Monument
 - - Concrete Monument
 - - 1" Iron Pipe
 - - 1" Iron Bar
 - △ - Mag Nail

RECEIVED BY LINCOLN COUNTY SURVEYOR THIS 6TH DAY OF January 20 06

Tony Walker
COUNTY SURVEYOR

R.E.L. 4080 N. 20TH AVE WAUSAU, WI 54401 (715)675-9784

CERTIFIED CORRECT:
David A. Renaud
DAVID A. RENAUD
S-2142
Registered Land Surveyor
DATE: 1-6-06

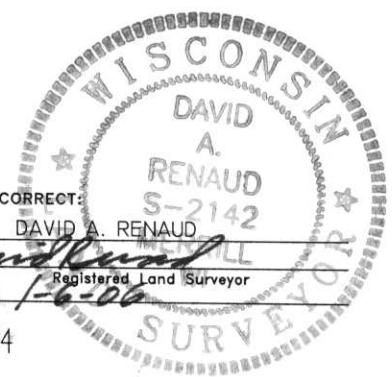

E-I: 21-25