




SECTION SUMMARY
 16 - 34 - 7
 Section Township Range
 SKANAWAN
 Town



N 216670.1530
 E 407390.4970

N 216646.5760
 E 410092.4960

N 216619.2544
 E 412790.5876

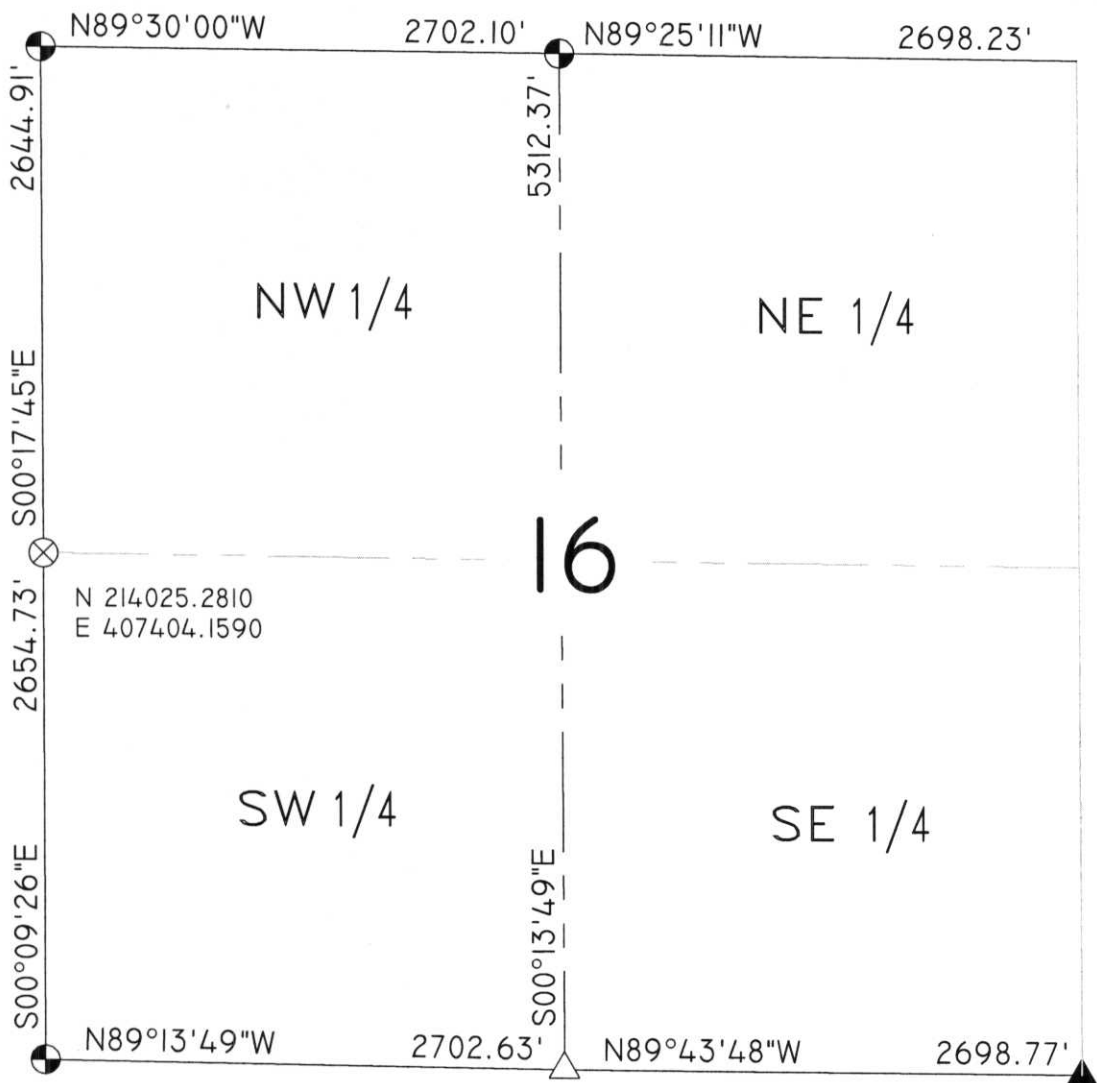

N 211370.5620
 E 407411.4490

N 211334.2520
 E 410113.8350

N 211321.5370
 E 412812.5739

COORDINATES ARE REFERENCED TO THE LINCOLN COUNTY COORDINATE SYSTEM AS DEVELOPED BY THE WISCONSIN DEPARTMENT OF TRANSPORTATION AND ARE BASED ON GPS OBSERVATIONS TO CONTROL POINTS AS SUPPLIED BY LINCOLN COUNTY.


LEGEND

- ⊙ - Lincoln County Monument (Berntsen)
- - Stone Monument
- - 1" Iron Pipe
- ▲ - PK Nail
- △ - Mag Nail
- ⊗ - 2" Iron Pipe

RECEIVED BY LINCOLN COUNTY
 SURVEYOR THIS 6TH DAY
 OF January 20 06
Tony Dell
 COUNTY SURVEYOR

CERTIFIED CORRECT:
 DAVID A. RENAUD
David A. Renaud
 Registered Land Surveyor

DATE: 1-6-06

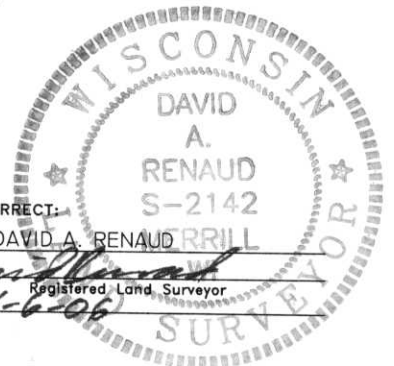

R.E.M. 4080 N. 20TH AVE WAUSAU, WI 54401 (715)675-9784

I-M: 9-13