
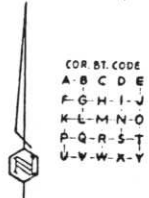


SEC. 33, T. 34 N., R. 7 E.,
LINCOLN COUNTY, WIS.

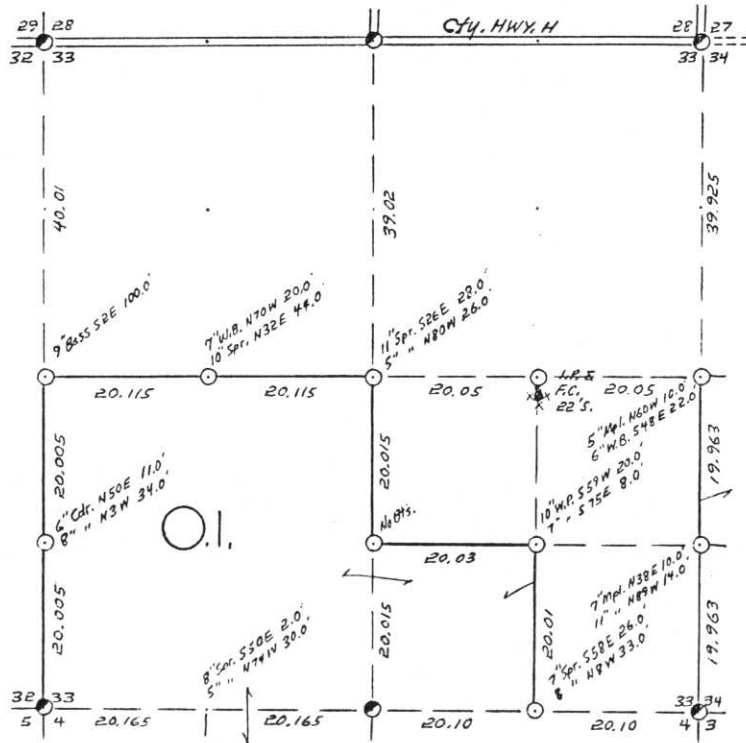

SCALE:
0 5 10 20 CHAINS
0 330 660 1320 FEET

LEGEND: CORNERS & LINES
 ○ IRON PIPE OR CAP
 ⊙ CONCRETE
 ⊕ POST
 △ STAKE
 † SPIKE
 ● BY OTHERS
 --- BLAZED - PAINTED
 --- BLAZED
 --- APPR. PAINTED
 --- RANDOM
 *** FENCE

Surveyed 1964

OWENS-ILLINOIS
TOWANAHA WISCONSIN
FOREST PRODUCTS DIVISION
Ownership Boundary Survey
DRAWN BY W.H. STUTZ
DATE 1/12/87

Prepared By W.H. Stutz 3/6/87

B FILE

0-4: 9-13

STATEMENT Transit & Chain Surv. using corners
found

RECORDS EXAMINED _____ DWG. NO. _____

Org. Surv.
County

Received from:

Nekoosa Paper Inc
Forest District Office
Minocqua, WI 54848

LOCAL CONTACTS _____

REMARKS _____

RECEIVED AT LINCOLN COUNTY
COURTHOUSE THIS 18 DAY
OF April 19 89.
Pat Oriebe
TAX DESCRIPTION OFFICE