




SECTION SUMMARY
 36 - 34 - 7
 Section Township Range
 SKANAWAN
 Town

N 200756.1680
 E 423315.9820

N 200839.5620
 E 425928.6270

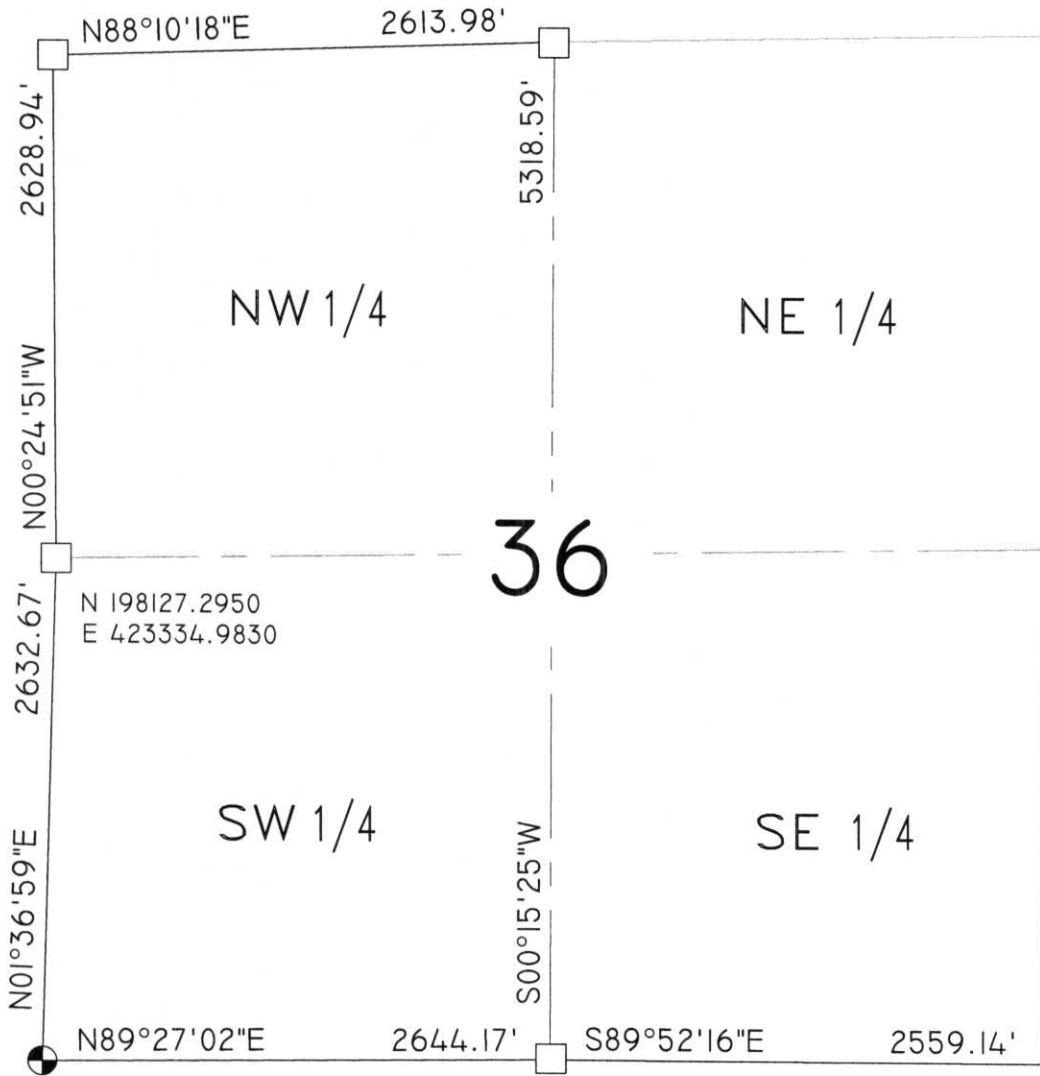

N 195495.6711
 E 423260.7199

N 195521.0250
 E 425904.7650

N 195515.2660
 E 428463.8960

COORDINATES ARE REFERENCED TO THE LINCOLN COUNTY COORDINATE SYSTEM AS DEVELOPED BY THE WISCONSIN DEPARTMENT OF TRANSPORTATION AND ARE BASED ON GPS OBSERVATIONS TO CONTROL POINTS AS SUPPLIED BY LINCOLN COUNTY.

- LEGEND**
- ⊙ - Lincoln County Monument (Berntsen)
 - - Stone Monument
 - - 1" Iron Pipe
 - - 1" Iron Bar
 - △ - Mag Nail

RECEIVED BY LINCOLN COUNTY
 SURVEYOR THIS 6TH DAY
 OF January 2006
Tommy Wall
 COUNTY SURVEYOR

CERTIFIED-CORRECT:
 DAVID A. RENAUD
David A. Renaud
 Registered Land Surveyor WI

DATE: 1-6-06



R.E.I., 4080 N. 20th AVE WAUSAU, WI 54401 (715)675-9784

U-1: 21-25