


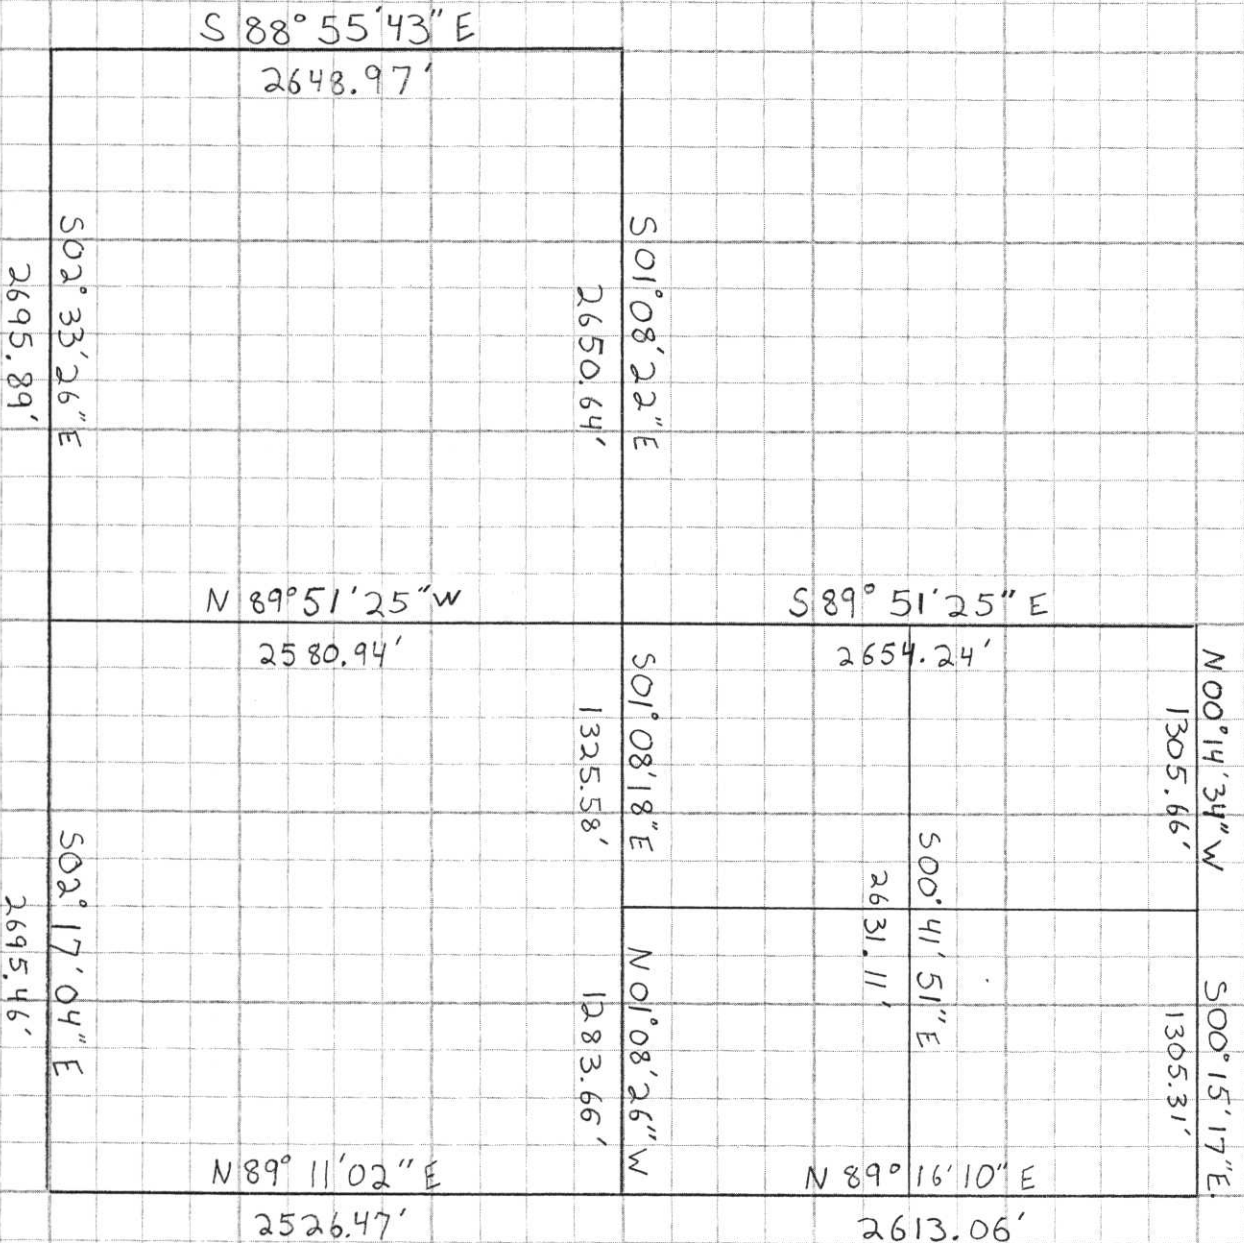

NOT TO
SCALE

SECTION 9 T. 35 N. R. 5 E



RECEIVED AT LINCOLN COUNTY
 COURTHOUSE THIS 25TH DAY
 OF October 20 01
Jamy Dahn
 LAND INFORMATION OFFICE

E.I.-9,13