
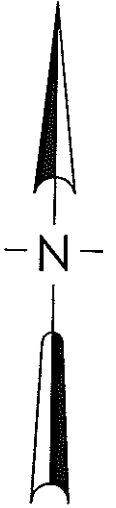


Lincoln County

SECTION SUMMARY

15	T35N	R5E
Section	Township	Range
WILSON		
Town		

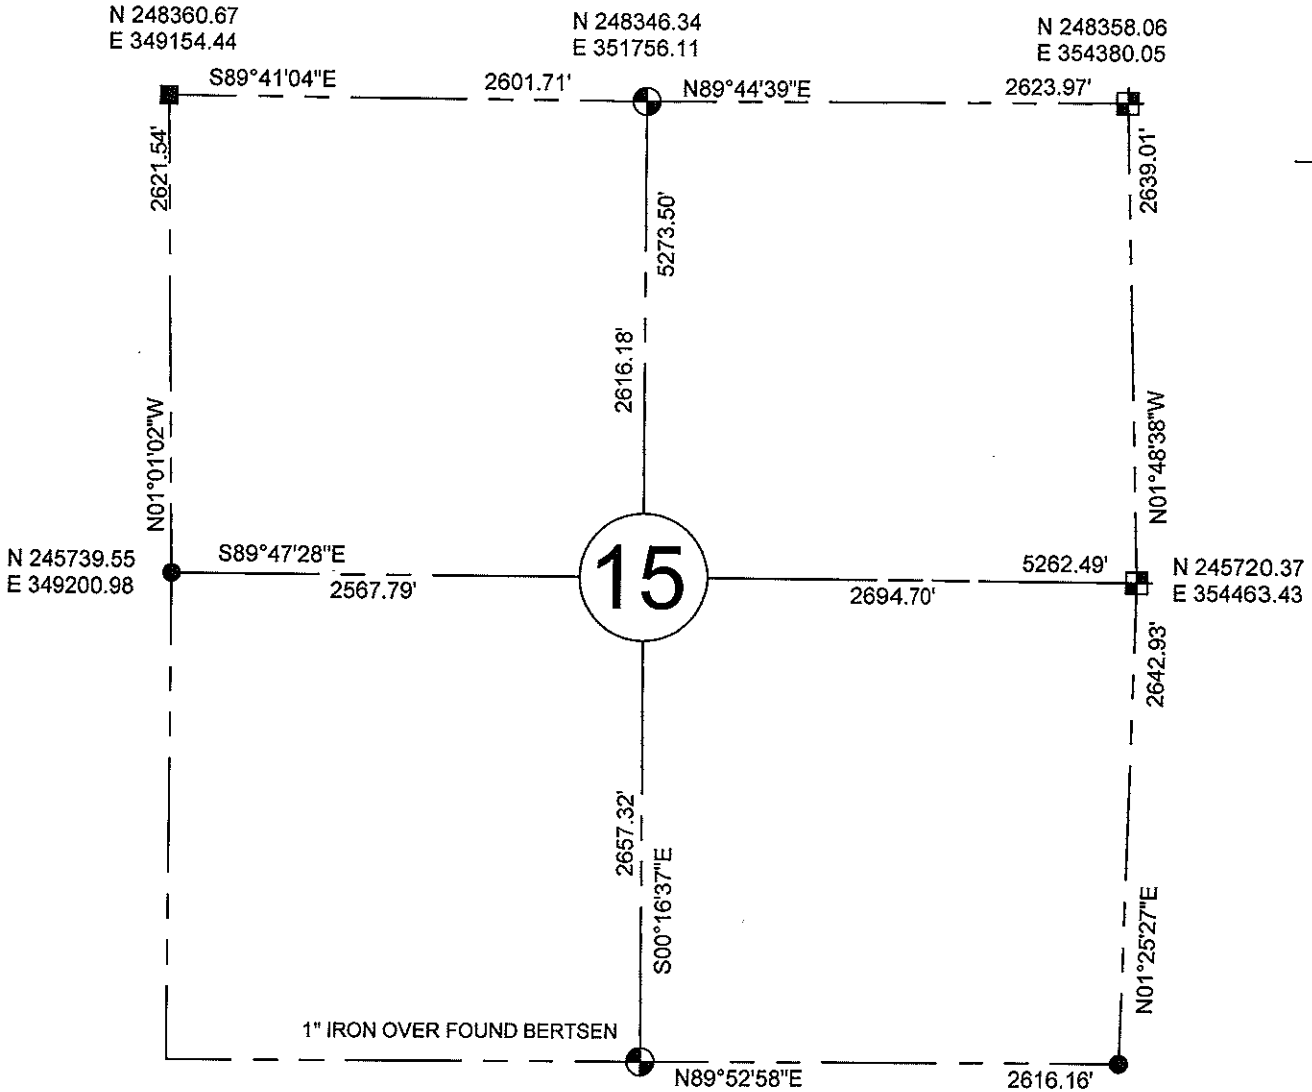

NOTE:
BEARINGS AND COORDINATES ARE BASED ON THE
LINCOLN COUNTY COORDINATE SYSTEM AND
REFERENCED TO THE WILSON GPS STATION.

SEAL

LEGEND

- BERTSEN MONUMENT
- FOUND MAG NAIL
- FOUND GRANITE STONE
- FOUND 2"X2" IRON

RECEIVED BY LINCOLN COUNTY
SURVEYOR THIS 30TH DAY
OF December 20 08
Terry Dallen
COUNTY SURVEYOR

CERTIFIED CORRECT:
Keith J. Walkowski

KEITH J. WALKOWSKI

Registered Land Surveyor

DATE: 12-21-08

