
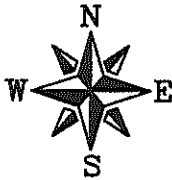


# LINCOLN COUNTY SECTION SUMMARY

## Legend


 Lincoln County Berntsen Monument

**16** — **35N** — **5E**  
 Section Township Range  
**Wilson**  
 Town




Proj. 878


Not to Scale

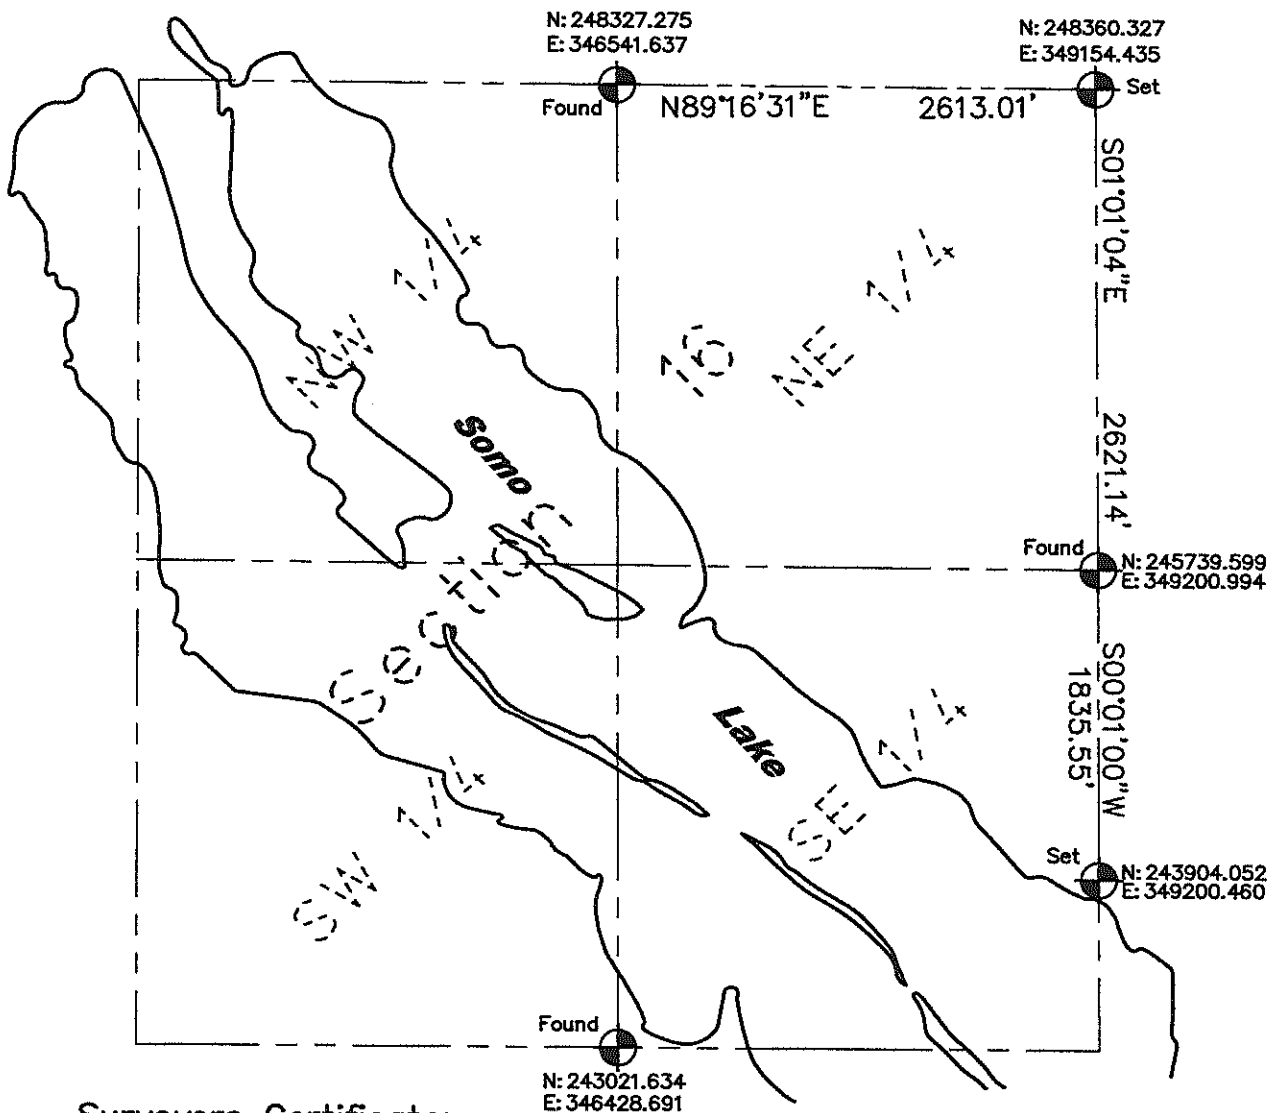


### Surveyors Certificate:

Coordinates and bearings are referenced to the Lincoln County Coordinate System as developed by the Wisconsin Department of Transportation and were determined by GPS observations on Control Station "Wilson GPS" as supplied by Lincoln County Land Information Office, to the best of my knowledge and belief.

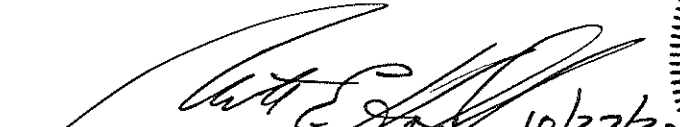  
 Matthew E. Hoglund, S-1910  
 Date 10/27/2009

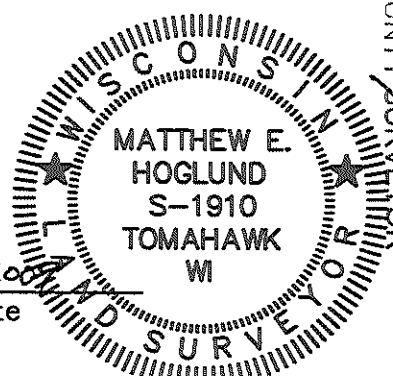

RECEIVED BY LINCOLN COUNTY  
 SURVEYOR THIS 28<sup>TH</sup> DAY  
 OF October 29 09  
 COUNTY SURVEYOR  


Sec. 16