



LINCOLN COUNTY SECTION SUMMARY

Legend

-  Found Lincoln County Berntsen Monument
-  Replaced Found PK Nail with Berntsen "SURVEY MARK" Nail

23 — **35N** — **5E**
 Section Township Range
Wilson
 Town


RECEIVED BY LINCOLN COUNTY
 SURVEYOR THIS 22ND DAY
 OF September 20 09

 COUNTY SURVEYOR



Proj. 878

Not to Scale

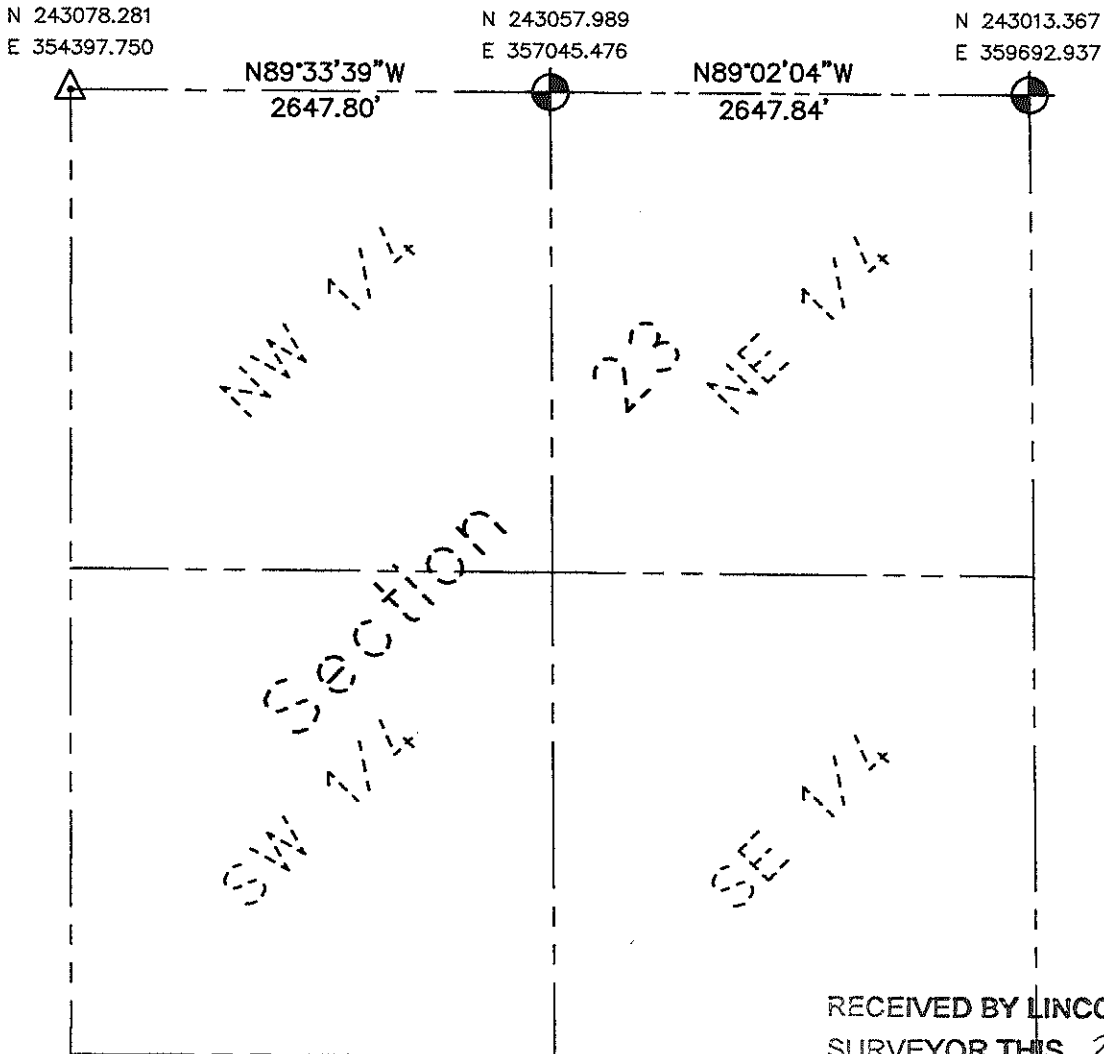


RECEIVED BY LINCOLN COUNTY
 SURVEYOR THIS 22ND DAY
 OF September 20 09

 COUNTY SURVEYOR

Surveyors Certificate:

Coordinates and bearings are referenced to the Lincoln County Coordinate System as developed by the Wisconsin Department of Transportation and were determined by GPS observations on Control Station "Wilson GPS" as supplied by Lincoln County Land Information Office, to the best of my knowledge and belief.

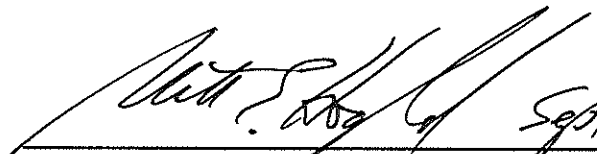
 Matthew E. Hoglund, S-1910

Sept. 22, 2009
 Date

