


4 - 35N - 6E
 Section Township Range
BRADLEY
 Town

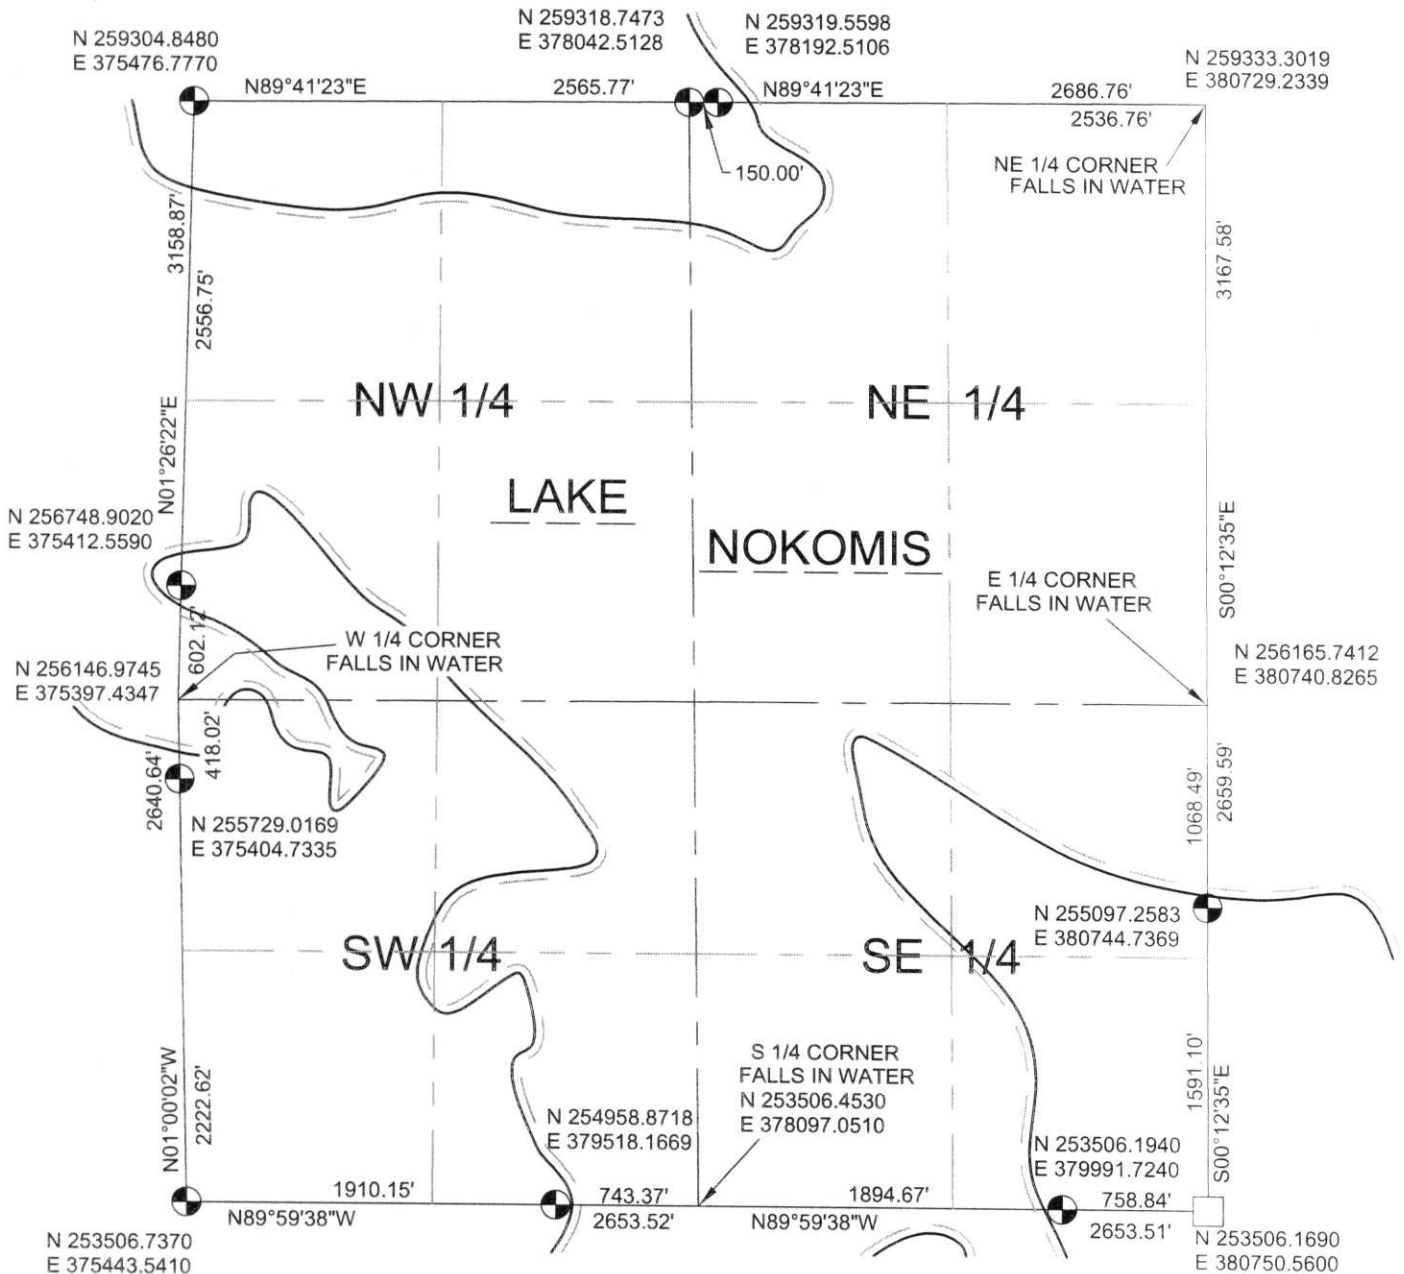

NOTES:
 COORDINATES AND BEARINGS ARE REFERENCED TO THE LINCOLN COUNTY COORDINATE SYSTEM AS DEVELOPED BY THE WISCONSIN DEPARTMENT OF TRANSPORTATION AND WERE DETERMINED BY GPS OBSERVATIONS ON CONTROL POINTS AS SUPPLIED BY THE DOT.

- LEGEND**
- ⊗ - Lincoln County Monument
 - - Concrete Monument
 - - 1" Iron Pipe
 - - Iron Bar
 - △ - Other

RECEIVED AT LINCOLN COUNTY
 COURTHOUSE THIS 21ST DAY
 OF December 20 01
Tony Dahn
 LAND INFORMATION OFFICE

WISCONSIN
 THOMAS A. RADENZ
 S-2095
 WAUSAU
 WI
 LAND SURVEYOR

CERTIFIED CORRECT:
Thomas A. Radenz
 Registered Land Surveyor
 DATE: 12/21/01

A.E. - 9,13