




SECTION SUMMARY

16	-	35N	-	6E
Section		Township		Range
<b>BRADLEY</b>				
Town				

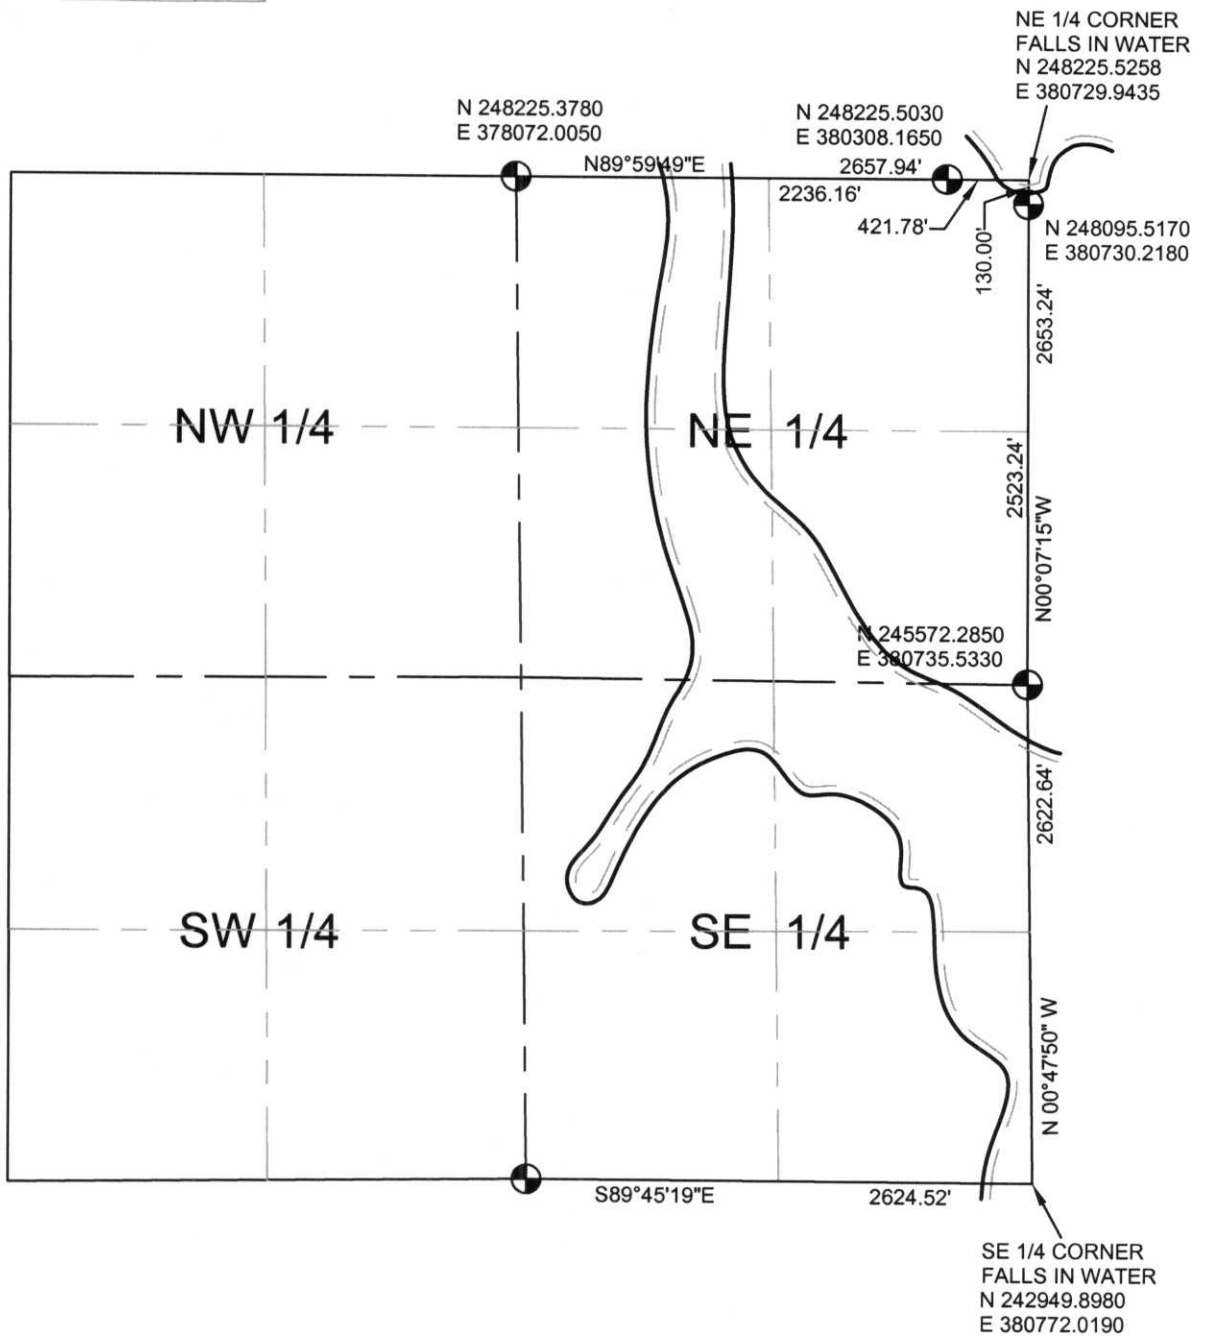

NOTES:  
COORDINATES AND BEARINGS ARE REFERENCED TO THE LINCOLN COUNTY COORDINATE SYSTEM AS DEVELOPED BY THE WISCONSIN DEPARTMENT OF TRANSPORTATION AND WERE DETERMINED BY GPS OBSERVATIONS ON CONTROL POINTS AS SUPPLIED BY THE DOT.


- LEGEND**
- ⊕ - Lincoln County Monument
  - - Stone Monument
  - - 2" Iron Pipe
  - - Iron Bar
  - △ - Other

RECEIVED AT LINCOLN COUNTY  
COURTHOUSE THIS 21<sup>ST</sup> DAY  
OF December 20 01  
*Tony Dallon*  
LAND INFORMATION OFFICE

CERTIFIED CORRECT:

*Thomas A. Radenz*  
Registered Land Surveyor


DATE: 12/21/01

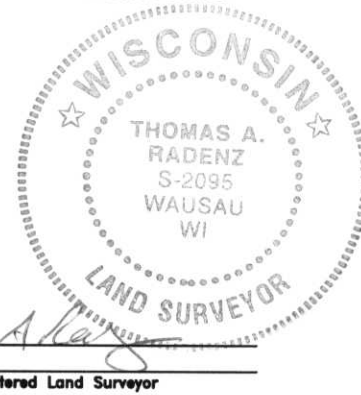

TM-9/13


Section Summary and Index

Section 16 Town 35 Range 60

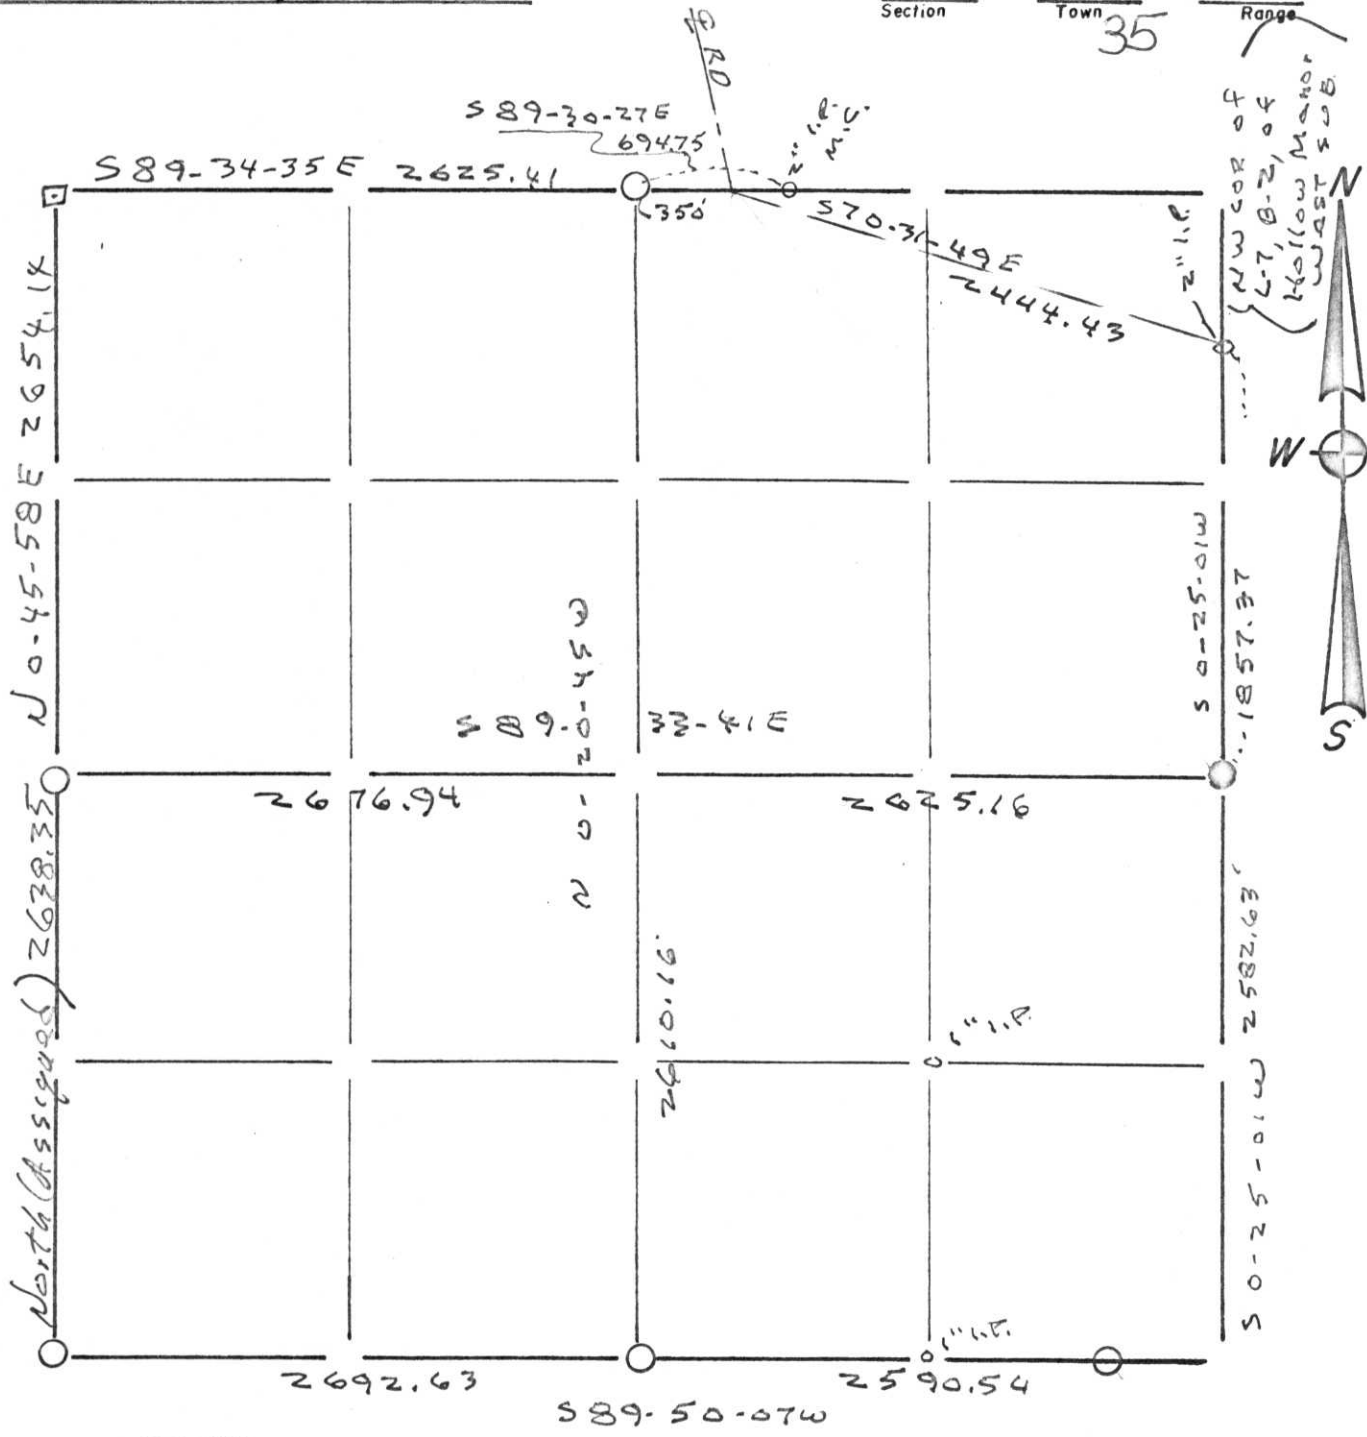

LEGEND

- ⊕ - Harrison cast iron monument.
- ⊠ - Stone or concrete monument.
- - Other Barstey Alum.
- - 4 x 4 wood post

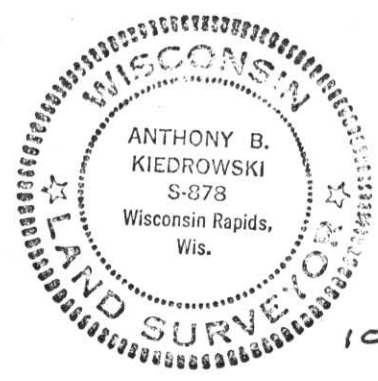

I, M - 9, 13

02/11/01

TAX DESCRIPTION OFFICE  
 OF \_\_\_\_\_ DAY \_\_\_\_\_  
 RECEIVED AT LINCOLN COUNTY COURTHOUSE THIS \_\_\_\_\_ DAY \_\_\_\_\_