




SECTION SUMMARY

17 - 35N - 6E
Section Township Range

BRADLEY
Town

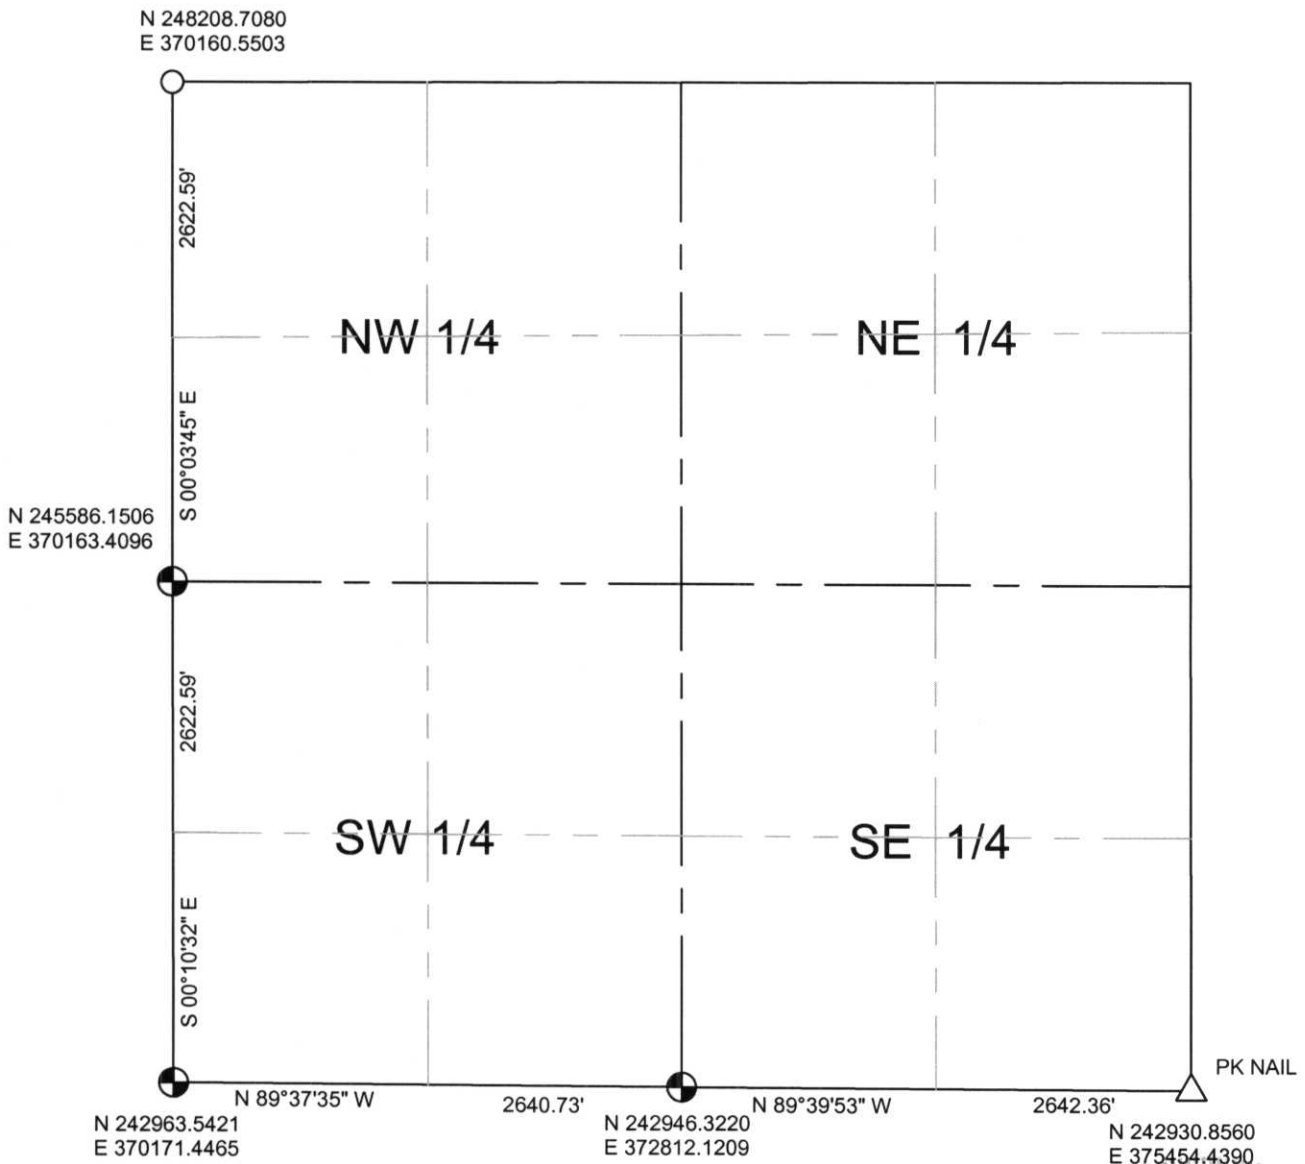

NOTES:
COORDINATES AND BEARINGS ARE REFERENCED TO THE LINCOLN COUNTY COORDINATE SYSTEM AS DEVELOPED BY THE WISCONSIN DEPARTMENT OF TRANSPORTATION AND WERE DETERMINED BY GPS OBSERVATIONS ON CONTROL POINTS AS SUPPLIED BY THE DOT.

LEGEND

- ⊕ - Lincoln County Monument
- - Stone Monument
- - 1" Iron Pipe
- - Iron Bar
- △ - Other

RECEIVED AT LINCOLN COUNTY
COURTHOUSE THIS 21ST DAY
OF December 20 01
Tony Dahn
LAND INFORMATION OFFICE



CERTIFIED CORRECT:

Thomas A. Radenz
Registered Land Surveyor

DATE: 12/21/01

6'5" - 6'11"