




SECTION SUMMARY  
 19 - 35N - 6E  
 Section Township Range  
**BRADLEY**  
 Town

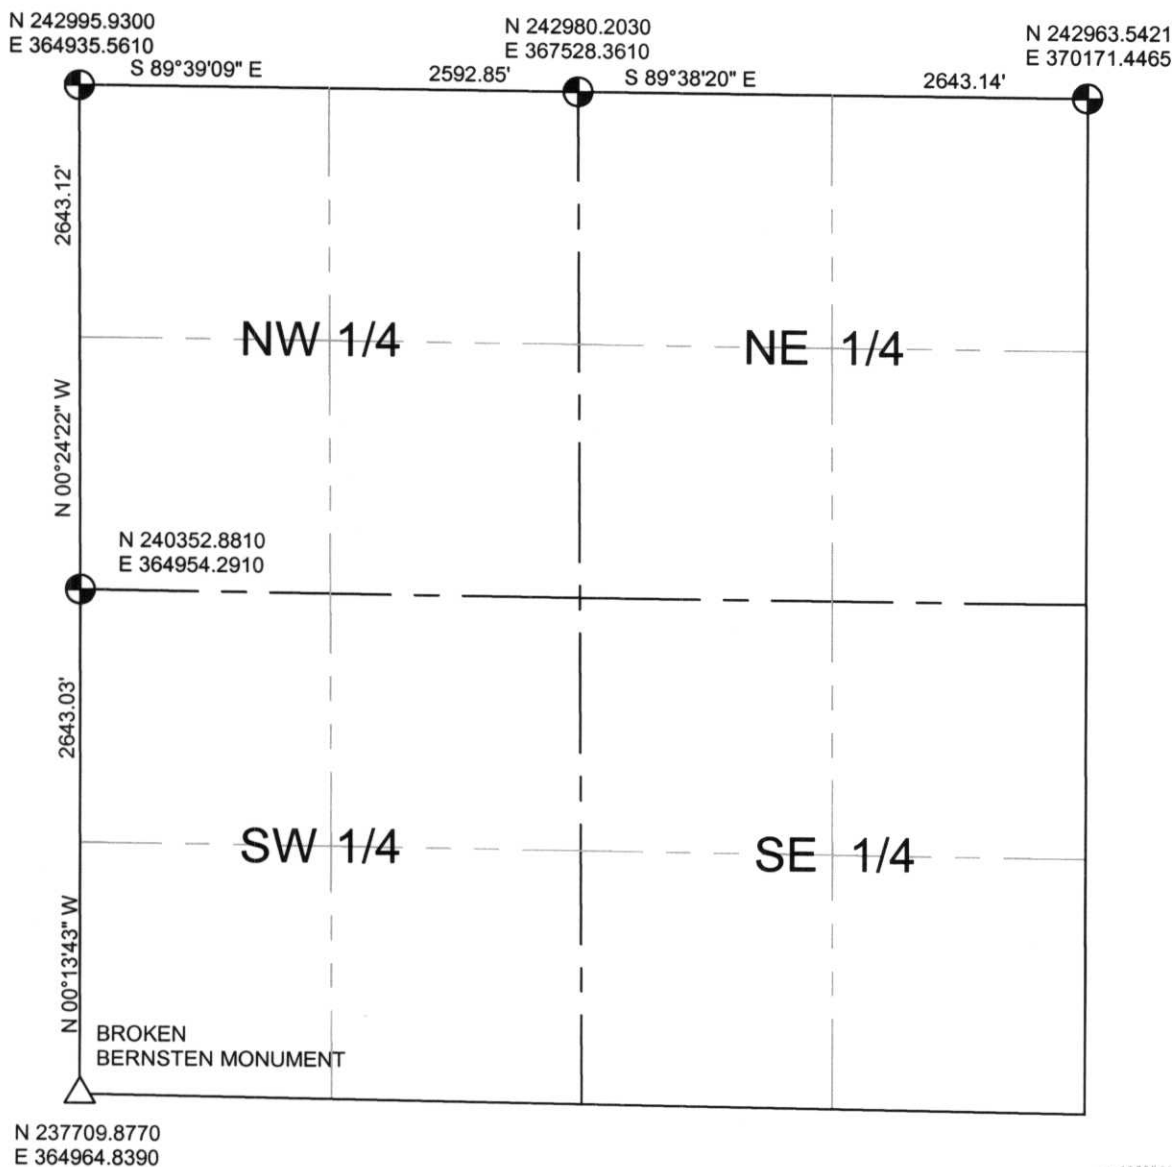

NOTES:  
 COORDINATES AND BEARINGS ARE REFERENCED TO THE LINCOLN COUNTY COORDINATE SYSTEM AS DEVELOPED BY THE WISCONSIN DEPARTMENT OF TRANSPORTATION AND WERE DETERMINED BY GPS OBSERVATIONS ON CONTROL POINTS AS SUPPLIED BY THE DOT.

- LEGEND**
- - Lincoln County Monument
  - - Stone Monument
  - - 2" Iron Pipe
  - - Iron Bar
  - △ - Other



RECEIVED AT LINCOLN COUNTY  
 COURTHOUSE THIS 21<sup>ST</sup> DAY  
 OF December 20 01  
*Tommy Dahn*  
 LAND INFORMATION OFFICE

CERTIFIED CORRECT:  
*Thomas A. Radenz*  
 Registered Land Surveyor  
 DATE: 12/21/01

M 0-25