


SECTION SUMMARY

27 - 35N - 6E
Section Township Range
BRADLEY
Town

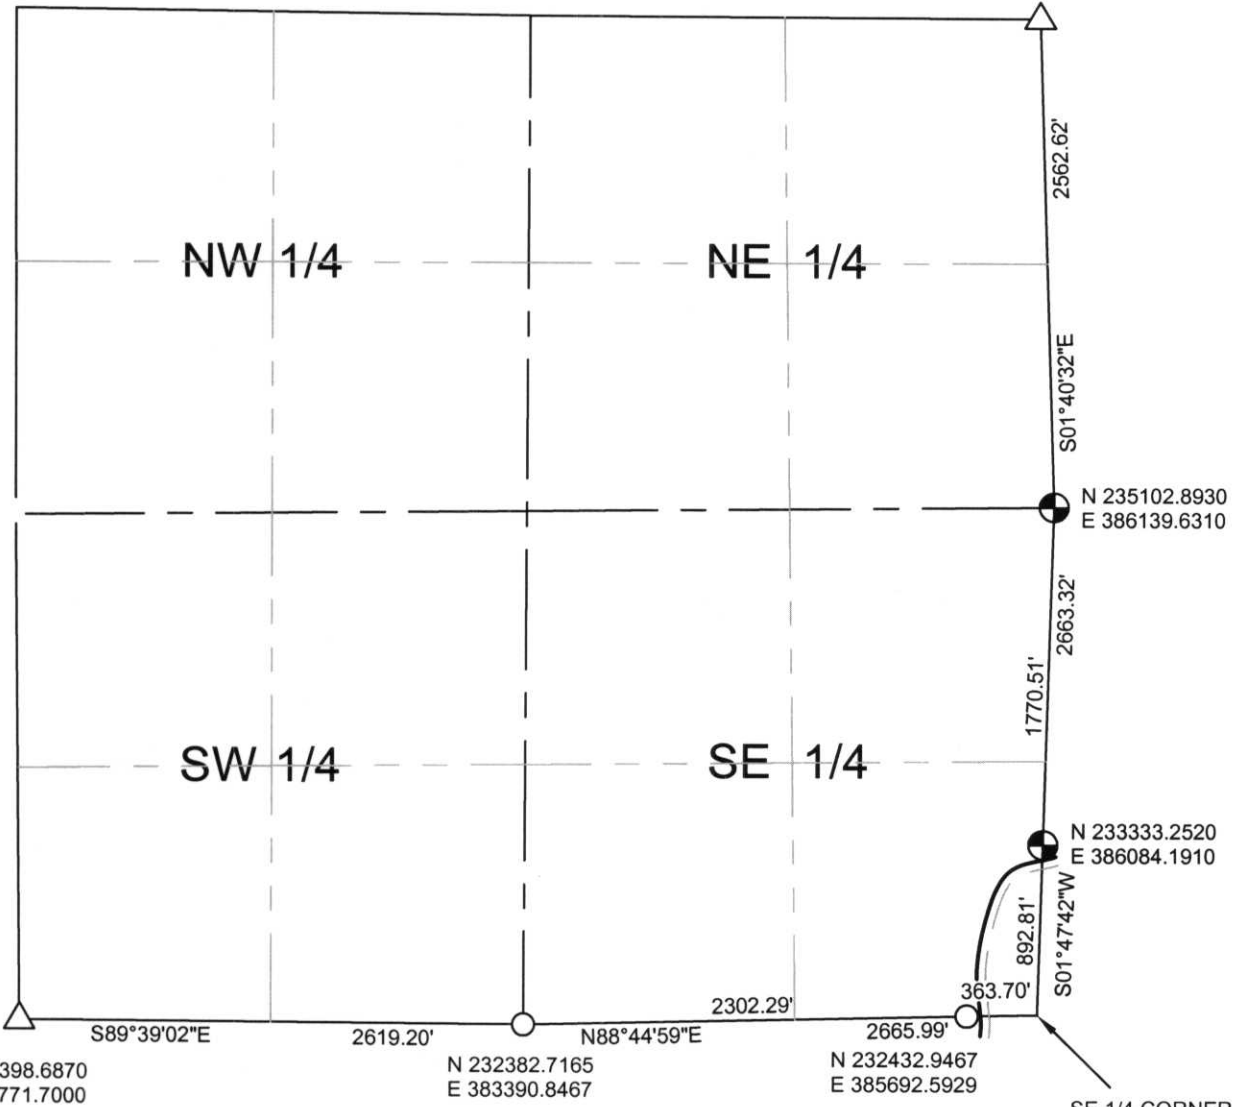

NOTES:
COORDINATES AND BEARINGS ARE REFERENCED TO THE LINCOLN COUNTY COORDINATE SYSTEM AS DEVELOPED BY THE WISCONSIN DEPARTMENT OF TRANSPORTATION AND WERE DETERMINED BY GPS OBSERVATIONS ON CONTROL POINTS AS SUPPLIED BY THE DOT.

LEGEND


- ⊕ - Lincoln County Monument
- - Stone Monument
- - 2" Iron Pipe
- - Iron Bar
- △ - PK NAIL

RECEIVED AT LINCOLN COUNTY
COURTHOUSE THIS 21ST DAY
OF December 20 01
Tom Dahn
LAND INFORMATION OFFICE

CERTIFIED CORRECT:

Thomas A. Radenz
Registered Land Surveyor

DATE: 12/21/01

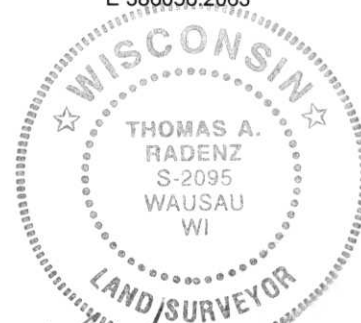

Q, N - 13, 17