


SECTION SUMMARY 28 - 35N - 6E  
Section Township Range  
**BRADLEY**  
Town

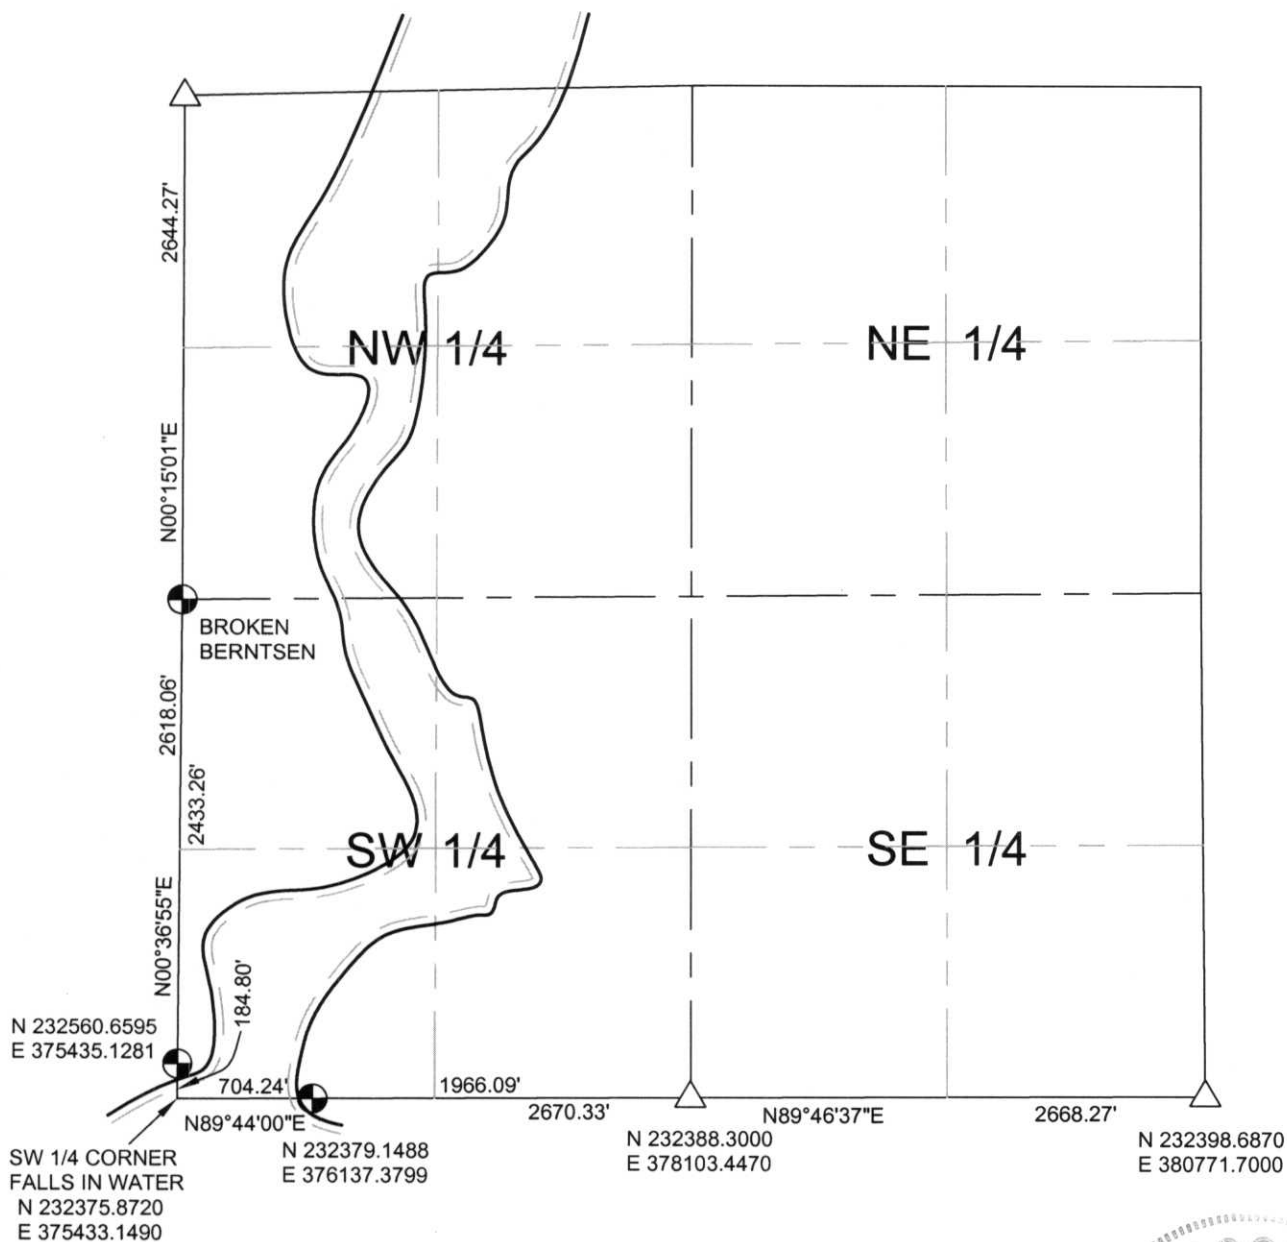

NOTES:  
COORDINATES AND BEARINGS ARE REFERENCED TO THE LINCOLN COUNTY COORDINATE SYSTEM AS DEVELOPED BY THE WISCONSIN DEPARTMENT OF TRANSPORTATION AND WERE DETERMINED BY GPS OBSERVATIONS ON CONTROL POINTS AS SUPPLIED BY THE DOT.

- LEGEND**
- - Lincoln County Monument
  - - Stone Monument
  - - 2" Iron Pipe
  - - Iron Bar
  - △ - PK NAIL

RECEIVED AT LINCOLN COUNTY  
COURTHOUSE THIS 21<sup>ST</sup> DAY  
OF December 20 01  
*Tony Dalko*  
LAND INFORMATION OFFICE



CERTIFIED CORRECT:  
*Thomas A. Radenz*  
Registered Land Surveyor  
DATE: 12/21/01

Q.M - 9,13