


DIAGRAM

OF

Township No. 35 North, Range No. 7

County, State of Wisconsin

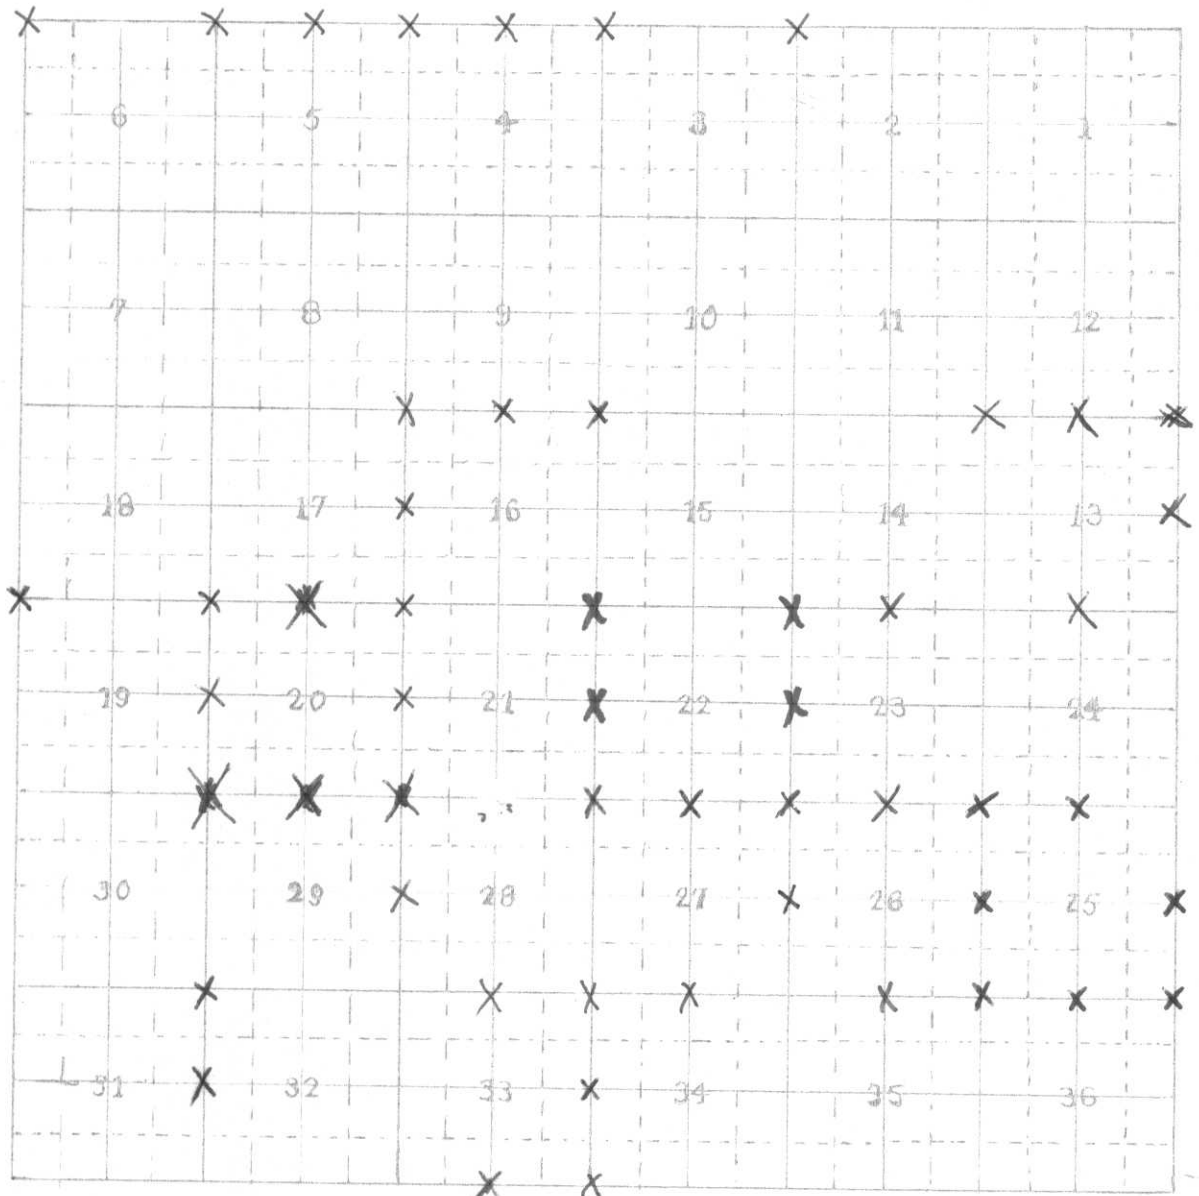

X-CORNER RESET
 O-CORNER MISSING
 #-CORNER FOUND