



SEC. 15, T.35 N., R. 7 E.,
LINCOLN COUNTY, WIS.

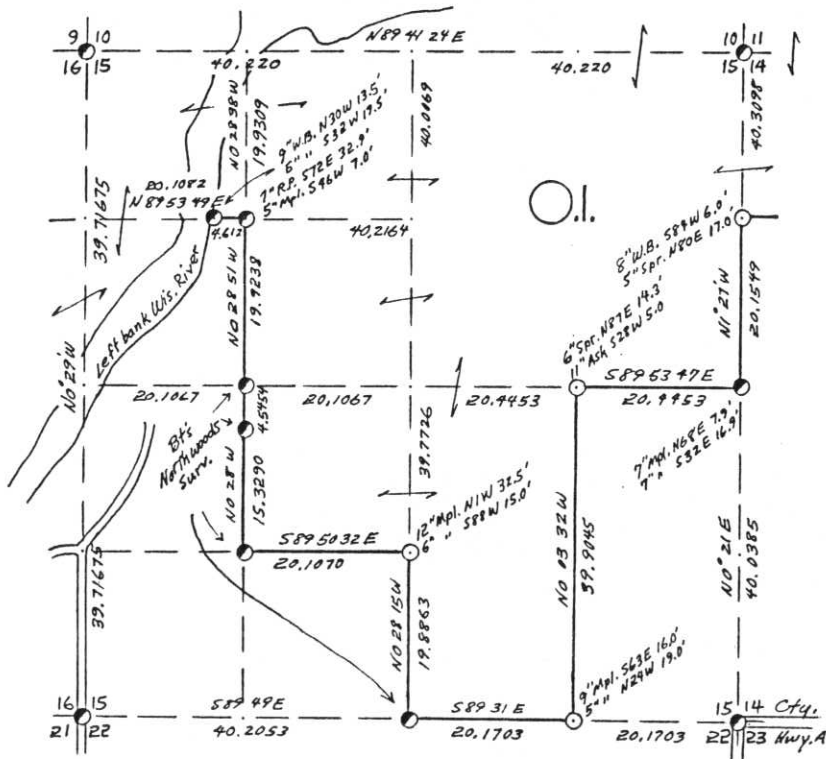

COR. BT. CODE
A-B-C-D-E
F-G-H-I-J
K-L-M-N-O
P-Q-R-S-T
U-V-W-X-Y

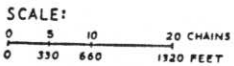

LEGEND: CORNERS & LINES
 ○ IRON PIPE OR CAP --- BLAZED - PAINTED
 ⊙ CONCRETE --- BLAZED
 ⊕ POST --- APPR. PAINTED
 △ STAKE --- RANDOM
 + SPIKE
 ● BY OTHERS --- FENCE

Surveyed 1980

OWENS-ILLINOIS
TOMAHAWK (I) WISCONSIN
FOREST PRODUCTS DIVISION

Ownership Boundary Survey
DRAWN BY W.H. Stuth
DATE 2/26/87

Prepared By W.H. Stuth 3/6/87

B FILE

I-m: 13-17

STATEMENT Transit & Chain Surv. using corners
found.

RECORDS EXAMINED _____ DWG. NO. _____
Org. Surv.
County
Northwoods Surveyors

Received from:
Dekoosa Papers Inc.
Forest District Office
Menomonie, WI
54548

LOCAL CONTACTS _____

REMARKS _____

RECEIVED AT LINCOLN COUNTY
 COURTHOUSE THIS 18 DAY
 OF April 19 89.
Pat Pruebe
 TAX DESCRIPTION OFFICE