


Lincoln County Surveyor

SECTION
SUMMARY

31	35	7
Section	Township	Range
KING		
Town		

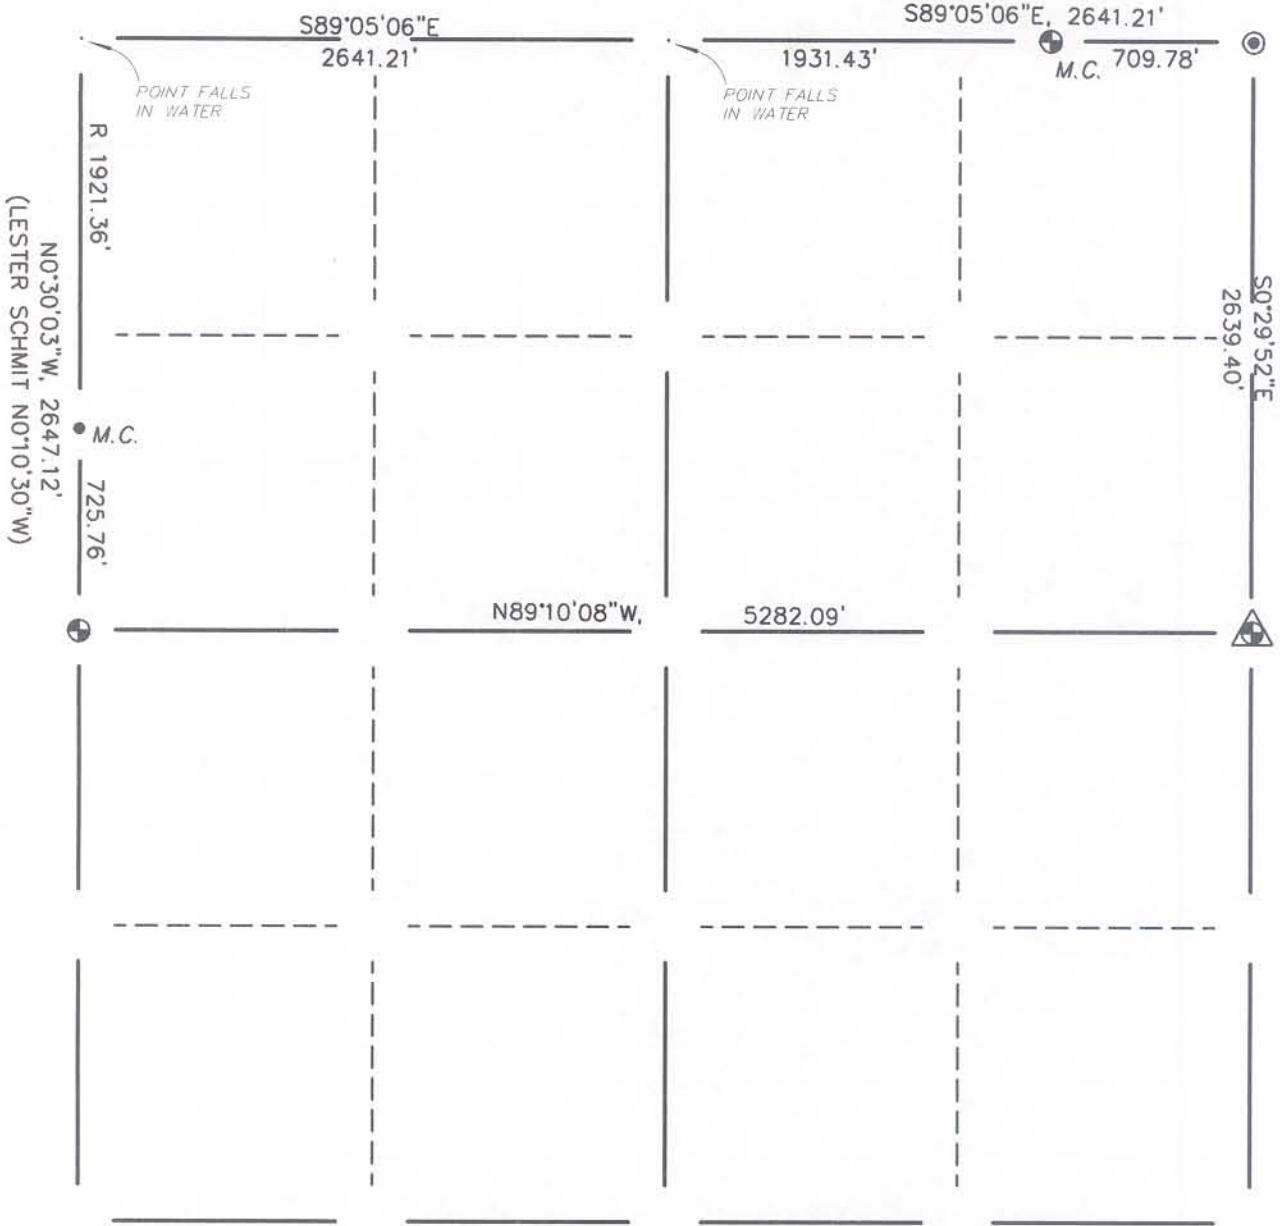

LEGEND

- ⊕ - Berntsen Monument
- ⊕ (with triangle) - 1" (od) Iron Pipe over Berntsen Monument
- - 1-1/2" (od) Iron Pipe
- ⊙ - 2" (od) Iron Pipe



CERTIFIED CORRECT:
William W. Nutter, RLS
William W. Nutter
 Registered Land Surveyor
 DATE: 4-7-2004