


# DIAGRAM

OF

Township No. 35 North, Range No. 8

County, State of Wisconsin

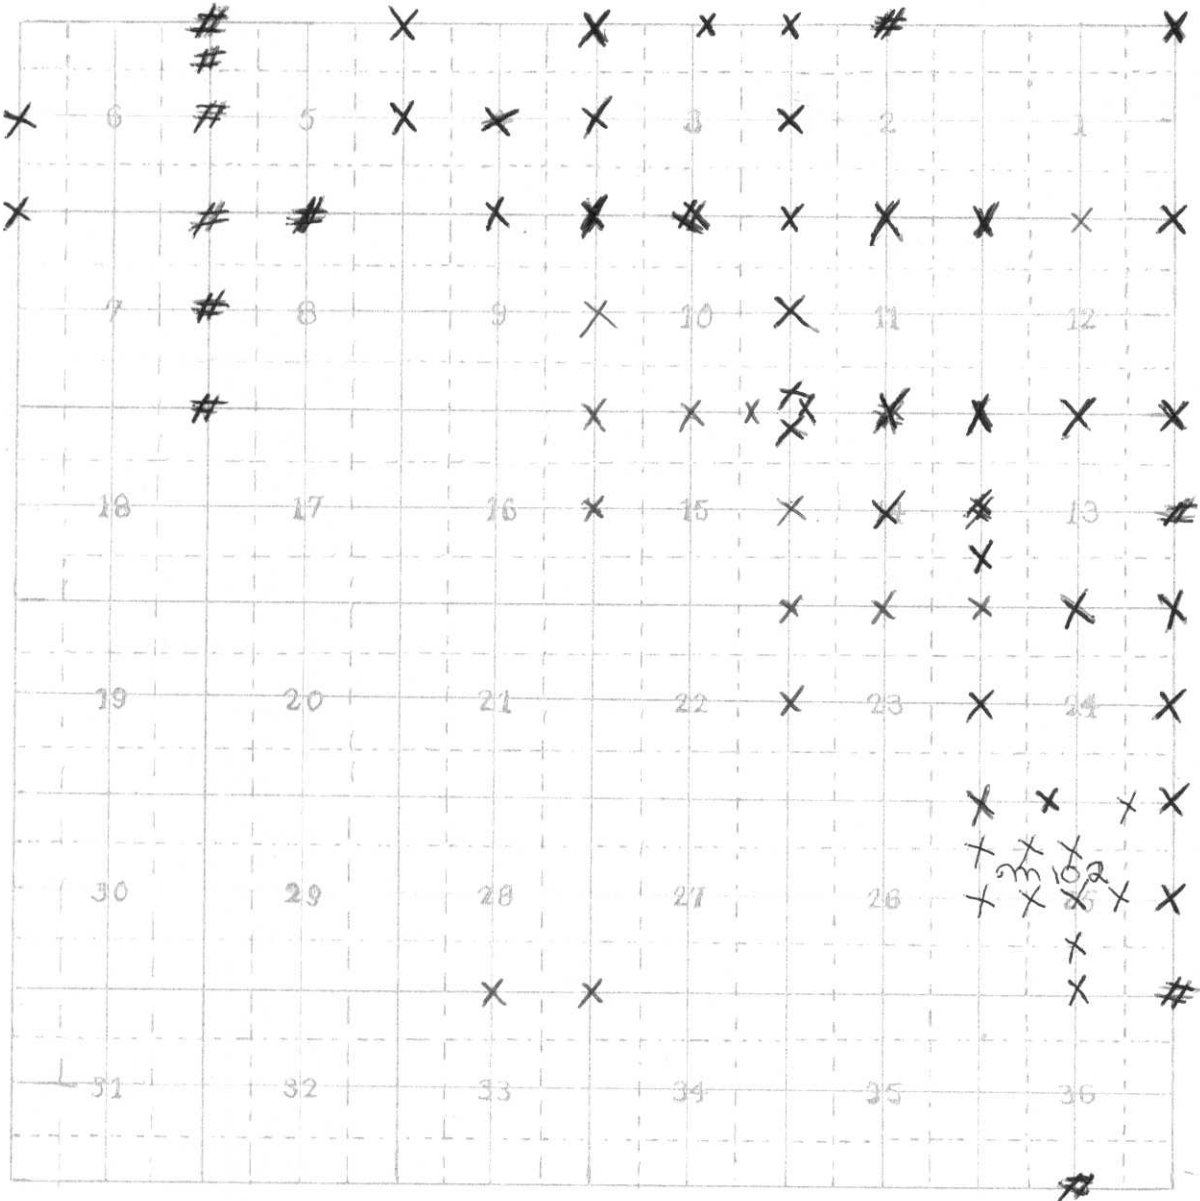

X-CORNER RESET  
 O-CORNER MISSING  
 #-CORNER FOUND

WISCONSIN  
 1901