

U.S. PUBLIC LAND SURVEY MONUMENT RECORD


Note: This form is intended and designed to fulfill all requirements of Wisconsin Administrative Code, Chapter A-E 5.02, U.S. Public Land Survey Monument Record (3) (a) (b) (c) (d) (e) (f) (g) (h) (i). An additional sheet may be added if necessary to conform with said requirements.

(a) Corner location: Township 31 North

Range 4 East

Town/City/Village CORNING

County LINCOLN

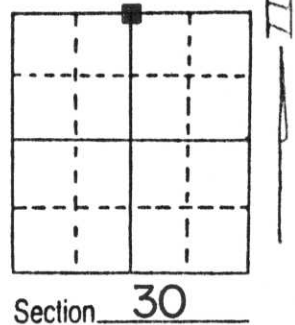


(b) (f) (g) (h) Description of monument found at this corner and if it was accepted, state all evidence (material, testimonial, occupational, plats, records, other monuments) used as a basis for accepting. If not accepted or if nothing was found, state evidence used as basis for establishing location. If reestablished through lost corner proportionate methods, indicate all monuments, distances and directions used to establish.

Used State Highway plan Project T020(5), S.T.H. "64", Medford to Merrill. Plan called for the corner to be 55 feet north of the highway centerline. Found 3" iron pipe in place accepted iron pipe as being on the $\frac{1}{4}$ section line as it fit well with highway stationing. Set Berntsen monument at the described location and included in section traverse.

**RECEIVED AT LINCOLN COUNTY
COURTHOUSE THIS 22nd DAY
OF Dec. 19 97
Pat Pribe
TAX DESCRIPTION OFFICE**

(c) (d) (e) Plan view of corner with ties to at least 4 witness monuments. If in disagreement with previously established corner, show the distances between the two corners and also indicate the ties to the disputed corner.

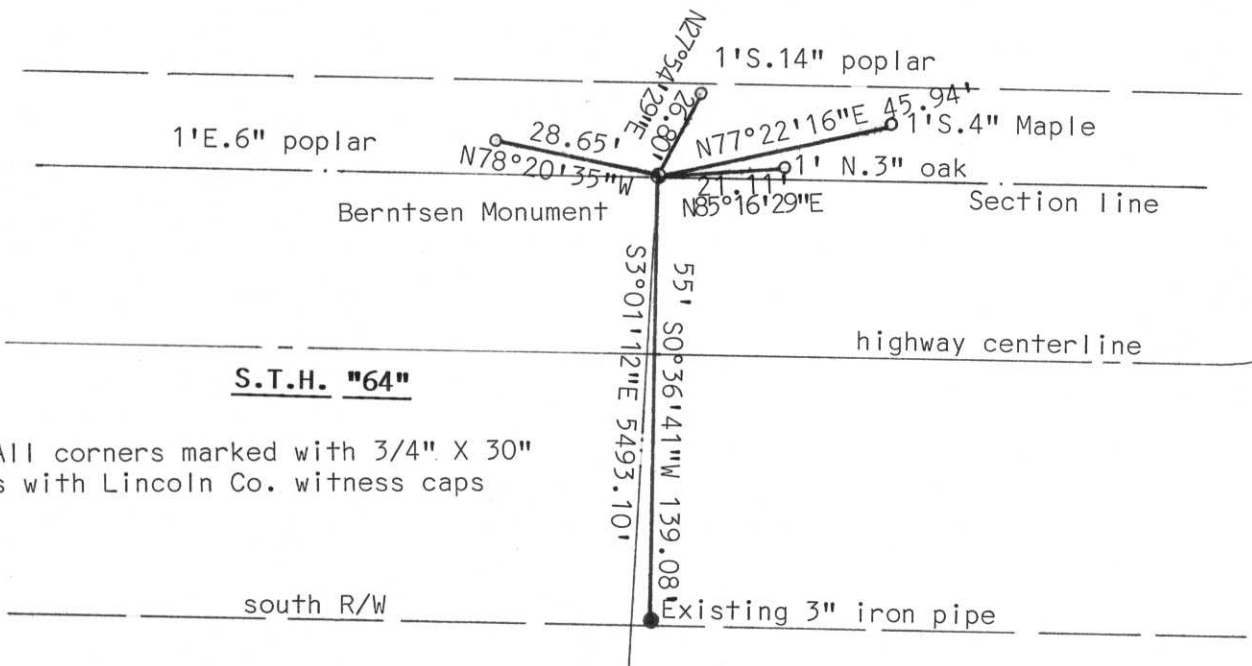

Note: All corners marked with 3/4" X 30" re-bars with Lincoln Co. witness caps

(i) I, Edwin R. Abendroth RLS No. S-798

(type or print name) certify that the corner location on this record was determined by me or under my direction and control and that this U.S. Public Land Survey Monument Record is correct and complete to the best of my knowledge and belief.

Edwin R. Abendroth December 19, 1997
Signature Date



Index No. Q-3



31 12:53 PM



31 12:54 PM



31 12:53 PM