

# LINCOLN COUNTY U.S. PUBLIC LAND TIE SHEET RECORD

SECTION 33  
TOWNSHIP 31N  
RANGE 4 E

333141  
NO.

LANDMARK

CORNING  
CITY, VILLAGE, TOWN


CORNER INDENTITY: BERNSTEN MONUMENT

LINCOLN COUNTY COORDINATE: N: 106124.2840

E: 311921.7650

DATE OF SURVEY: October 10, 2006

SURVEY PARTY: Rutzen/Jacobson

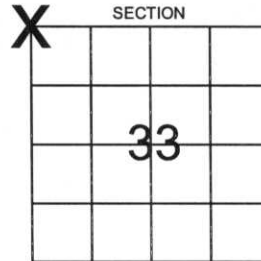

FOUND   
SET   
RE-SET   
RE-TIED




Description of monument found at this corner and if was accepted, state all evidence (material, testimonial, occupational, plats, records, other monuments) used as a basis for accepting. If not accepted or if nothing was found, state evidence used as basis for establishing location. If reestablished through lost corner proportionate methods, indicate all monuments, distances and directions used to establish.

## BASIS FOR MONUMENT LOCATION:

(DESCRIBE METHOD OF SURVEY AND CORNER AUTHENTICATION)

Monument was set based on found fenceline, blue line evidence, and roadway evidence found in the field.

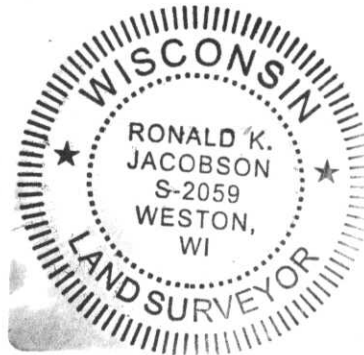

CERTIFIED CORRECT:

*[Signature]*


Ronald Jacobson RLS 2059-008  
Registered Land Surveyor

DATE: October 16, 2006

COMPANY: Central Wisconsin Engineers & Architects  
5707 Schofield Ave.  
Weston, Wisconsin 54476  
(715) 359-9400

## TIE SKETCH:

SHOW MINIMUM OF FOUR (4) HORIZONTAL TIE DISTANCES TO FIXED WITNESS MONUMENTS.  
DESCRIBE ALL MONUMENTS FOUND OR SET. ALL DISTANCES SHOWN IN US SURVEY FEET.

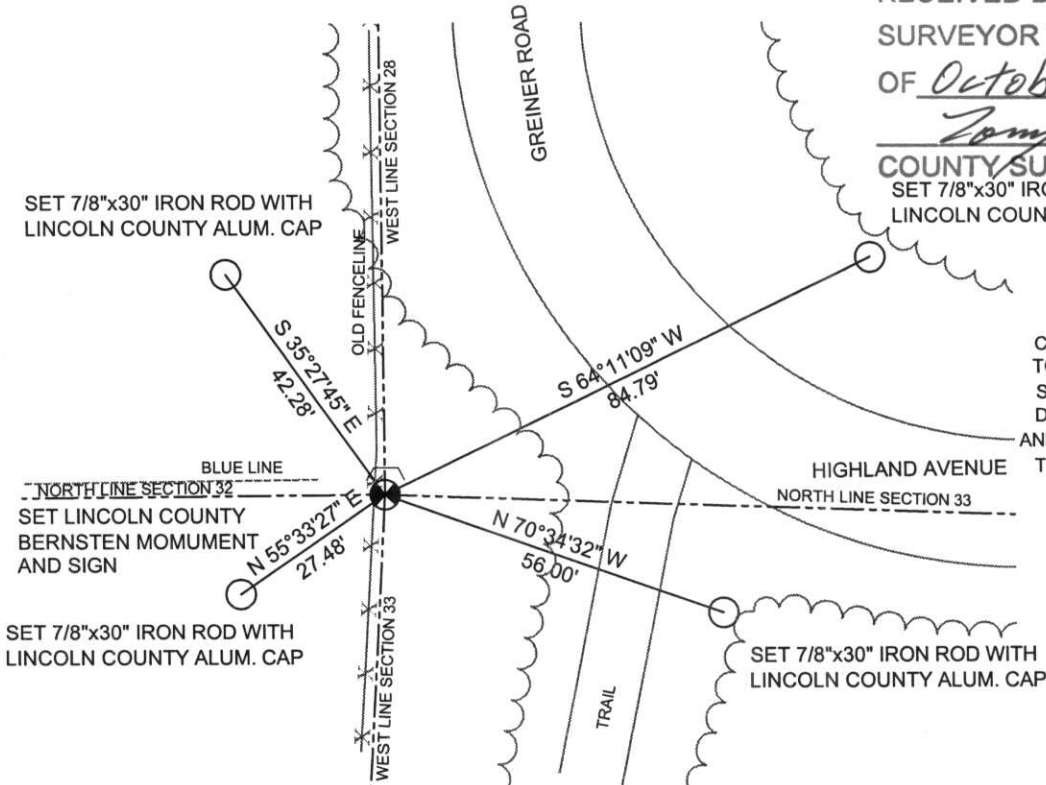

RECEIVED BY LINCOLN COUNTY  
SURVEYOR THIS 23<sup>RD</sup> DAY  
OF October 20, 06

*[Signature]*  
COUNTY SURVEYOR  
SET 7/8"x30" IRON ROD WITH  
LINCOLN COUNTY ALUM. CAP

COORDINATES ARE REFERENCED TO LINCOLN COUNTY COORDINATE SYSTEM AS DEVELOPED BY THE WI. DEPARTMENT OF TRANSPORTATION AND ARE BASED ON GPS OBSERVATIONS TO CONTROL POINTS AS SUPPLIED BY LINCOLN COUNTY.



NOT TO SCALE  
BEARINGS REFERENCED TO LINCOLN COUNTY COORDINATE SYSTEM









