

LINCOLN COUNTY U.S. PUBLIC LAND TIE SHEET RECORD

SECTION 31
TOWNSHIP 31N
RANGE 4 E

313147
NO.

LANDMARK


CORNING
CITY, VILLAGE, TOWN

CORNER INDENTITY: BERNSTEN MONUMENT

LINCOLN COUNTY COORDINATE: N: 100680.6070
E: 303687.8880

DATE OF SURVEY: September 19, 2006
SURVEY PARTY: Rutzen/Jacobson

FOUND
SET
RE-SET
RE-TIED

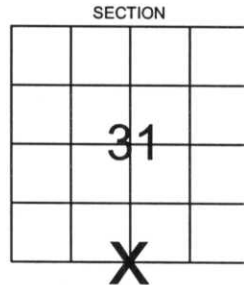

Description of monument found at this corner and if was accepted, state all evidence (material, testimonial, occupational, plats, records, other monuments) used as a basis for accepting. If not accepted or if nothing was found, state evidence used as basis for establishing location. If reestablished through lost corner proportionate methods, indicate all monuments, distances and directions used to establish.

BASIS FOR MONUMENT LOCATION:

(DESCRIBE METHOD OF SURVEY AND CONER AUTHENTICATION)

Monument was set based on found Marathon County corners, comparison of original notes, 1923 retracement notes from Marathon County and evidence found in the field.



RECEIVED BY LINCOLN COUNTY
SURVEYOR THIS 29TH DAY
OF September 20 06
Tony Ball
COUNTY SURVEYOR

CERTIFIED CORRECT:


Ronald Jacobson
Registered Land Surveyor
RLS 2059-008

COMPANY: Central Wisconsin Engineers & Architects
5707 Schofield Ave.
Weston, Wisconsin 54476
(715) 359-3400

DATE: September 26, 2006

TIE SKETCH:

SHOW MINIMUM OF FOUR (4) HORIZONTAL TIE DISTANCES TO FIXED WITNESS MONUMENTS.
DESCRIBE ALL MONUMENTS FOUND OR SET. ALL DISTANCES SHOWN IN US SURVEY FEET.

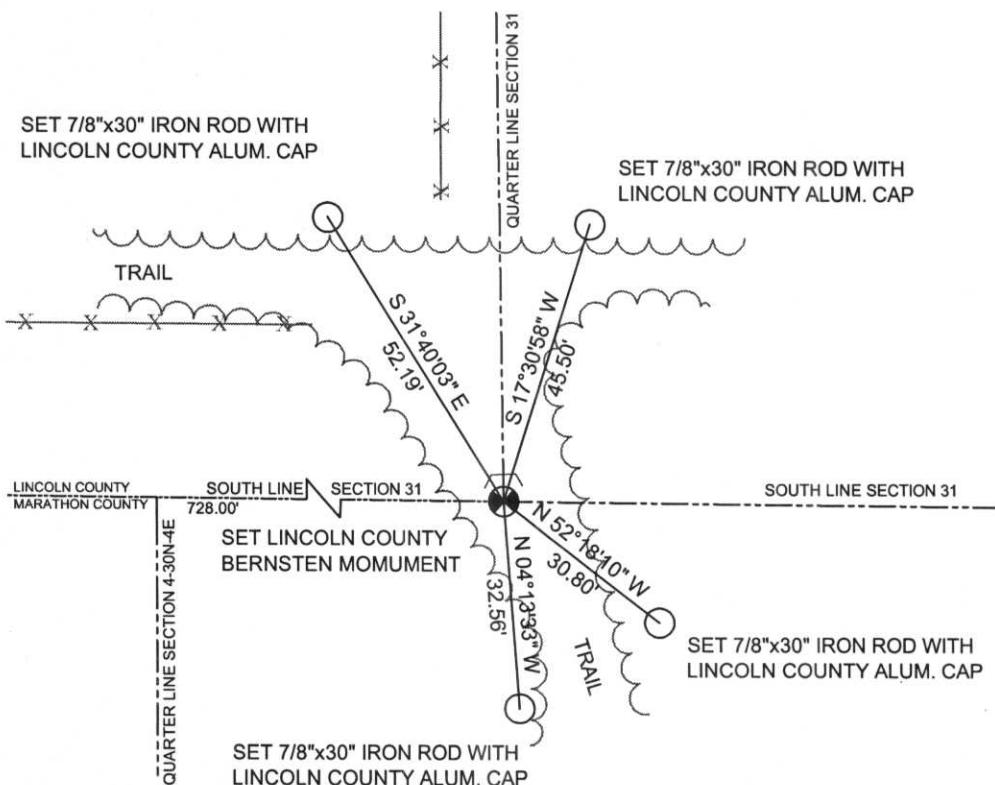

COORDINATES ARE REFERENCED TO LINCOLN COUNTY COORDINATE SYSTEM AS DEVELOPED BY THE WI. DEPARTMENT OF TRANSPORTATION AND ARE BASED ON GPS OBSERVATIONS TO CONTROL POINTS AS SUPPLIED BY LINCOLN COUNTY.

NOT TO SCALE
BEARINGS REFERENCED TO LINCOLN COUNTY COORDINATE SYSTEM



8.0 CM
DIST. 1
UNITS



PLEASE
DO NOT
DISTURB
NEARBY

SURVEY
MARKERS

WARNING: YOU must wear proper eye
protection when driving any object

THE
LOCATION
OF THE MARKER
SHOULD BE
RECORDED
ON THE
PROPERTY
DEED







PLEASE
DO NOT
DISTURB
NEARBY

S
M
U
R
R
V
E
Y
R

IF THE
LOCATION
OF THE MARKER IS
ENDANGERED
PLEASE CONTACT
THE COUNTY
SURVEYING
DEPT.

