

MARATHON COUNTY

SURVEY MONUMENT LOCATION RECORD

SECTION 1
TOWNSHIP 30
RANGE 4

12
NO.

LANDMARK BENCHMARK _____ FOUND SET

CORNER IDENTITY: 6" sq. White Sandstone Mon RE - SET RE - TIED

STATE PLANE COORDINATE: N: _____

ZONE: _____ E: _____


ELEVATION - (FEET): _____ DATUM: _____

THETA ANGLE: _____ WEATHER: Cloudy

DATE OF SURVEY: Aug. 13, 1982 TEMPERATURE: 70 °F

SURVEY PARTY: L. Mosher, R. Engelman

Halsey
CITY, VILLAGE, TOWN

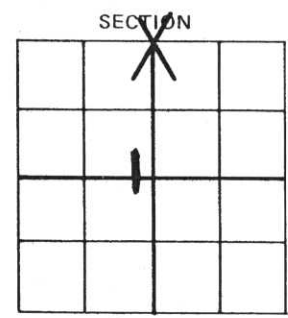

SECTION
LOCATION
(Indicated By X)



BASIS FOR MONUMENT LOCATION:

(DESCRIBE METHOD OF SURVEY AND CORNER AUTHENTICATION)

Recovered intact a 6" square white sandstone monument flush with granite roadway surface. Set RR spike along West edge of stone to aid location. ^{SEAL}



CERTIFIED CORRECT:

LoVerne H Mosher


FIELD BOOK NO. _____ PAGE NO. _____

COMPANY LHM Surveying

Registered Land Surveyor
DATE: August 17, 1982

TIE SKETCH:

SHOW MINIMUM OF THREE (3) HORIZONTAL TIE DISTANCES TO FIXED WITNESS MONUMENTS. DESCRIBE ALL MONUMENTS FOUND OR SET. CORRECT ALL DISTANCES SHOWN TO STANDARD TEMPERATURE OF 68° F.

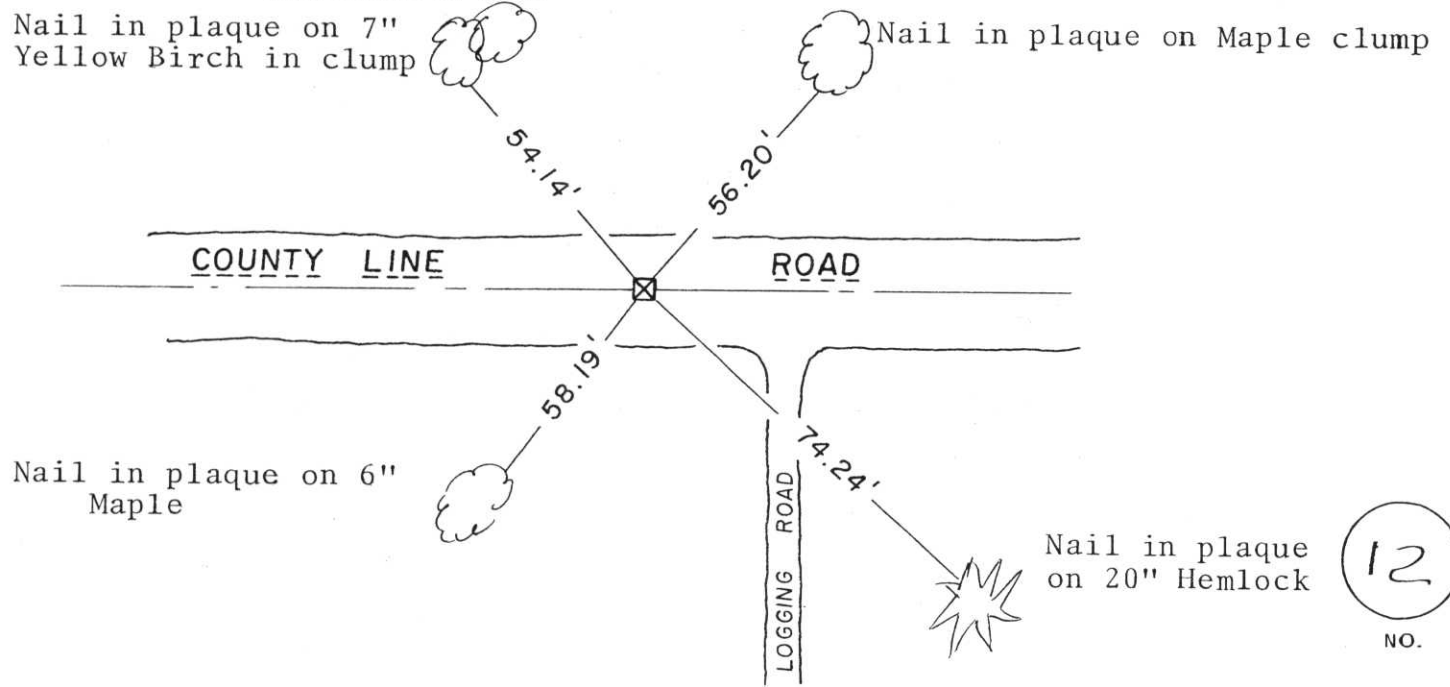

12
NO.

1-14-15