

CERTIFIED LAND CORNER RESTORATION

Index No. 4-11

State of Wisconsin }  
County of Lincoln } ss.

I Edwin R. Abendroth do hereby certify that on the 20th day of July, 19 83, I found evidence of the South 1/4 corner of Section 28 Township 31, North, Range 5 East, Fourth, Principal Meridian, as described hereon; and that from this evidence I established a new monument and accessories as described hereon to perpetuate the original location of this corner.

Resident witnesses:  
.....  
.....  
.....


History of original corner establishment:  
Date: October 1852  
Surveyor: Rick A. Chaney  
Monument: Wood Post  
Witnesses: No original witnesses found

Description of corner evidence found:  
We excavated at the road and the fence line intersection and found a 6" X 6" stone monument with cross in good condition, but tipped to the east. We straightened stone and placed a 2" iron pipe at north side to aid in location. Set several witness monuments.



Description of monument and accessories I established to perpetuate the original location of this corner.

(SEE BACK OF SHEET)

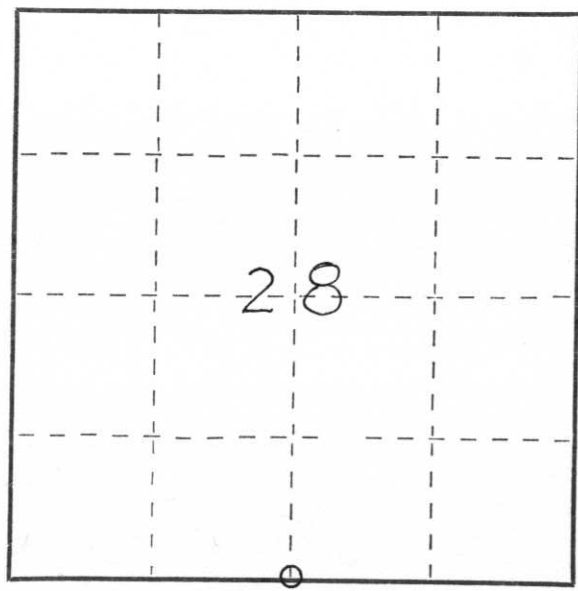

○ = Corner monument restored.

Dated at WAUSAU, Wis., this 28TH day of JULY, 19 83.

Signature Edwin R. Abendroth Surveyor Registration No. S-798  
(County Surveyor, Registered Land Surveyor, or other duly authorized official)

Office of Register of Deeds, County of \_\_\_\_\_, I hereby certify that the within instrument was filed in this office for record on the \_\_\_\_\_ day of \_\_\_\_\_, 19 \_\_\_\_\_ at \_\_\_\_\_ o'clock \_\_\_\_\_ M.

.....  
(Register of Deeds)

By \_\_\_\_\_ Deputy

RECEIVED AT LINCOLN COUNTY  
COURTHOUSE THIS 29th DAY  
OF July 1983.  
Ant. Shiblee  
TAX DESCRIPTION OFFICE

