


MARATHON COUNTY

SURVEY MONUMENT LOCATION RECORD


LANDMARK BENCHMARK _____
 CORNER IDENTITY: N 1/4 CORNER
 STATE PLANE COORDINATE: N: _____
 ZONE: _____ E: _____
 ELEVATION - (FEET): _____ DATUM: _____
 THETA ANGLE: _____ WEATHER: _____
 DATE OF SURVEY: _____ TEMPERATURE: _____ °F
 SURVEY PARTY: _____

FOUND SET
 RE-SET
 RE-TIED

SECTION 34
 TOWNSHIP 30
 RANGE 5

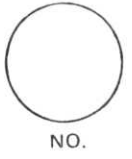

Hamburg
 CITY, VILLAGE, TOWN
 SECTION 32
Sec 31-5

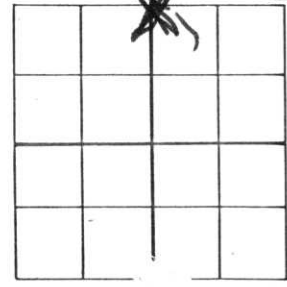

LOC. (Indicated By X)




BASIS FOR MONUMENT LOCATION:

(DESCRIBE METHOD OF SURVEY AND CORNER AUTHENTICATION)

FOUND GRANITE MONUMENT 1' BELOW SURFACE, 11-16-78.

SEAL

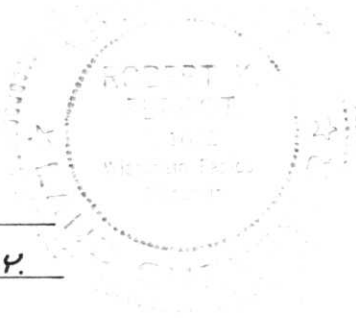


FIELD BOOK NO. FF PAGE NO. _____
 COMPANY MARATHON CO. HWY.

CERTIFIED CORRECT:
Robert K. Foyet
 Registered Land Surveyor
 DATE: Sept 20, 1979

TIE SKETCH:


SHOW MINIMUM OF THREE (3) HORIZONTAL TIE DISTANCES TO FIXED WITNESS MONUMENTS. DESCRIBE ALL MONUMENTS FOUND OR SET. CORRECT ALL DISTANCES SHOWN TO STANDARD TEMPERATURE OF 68° F.

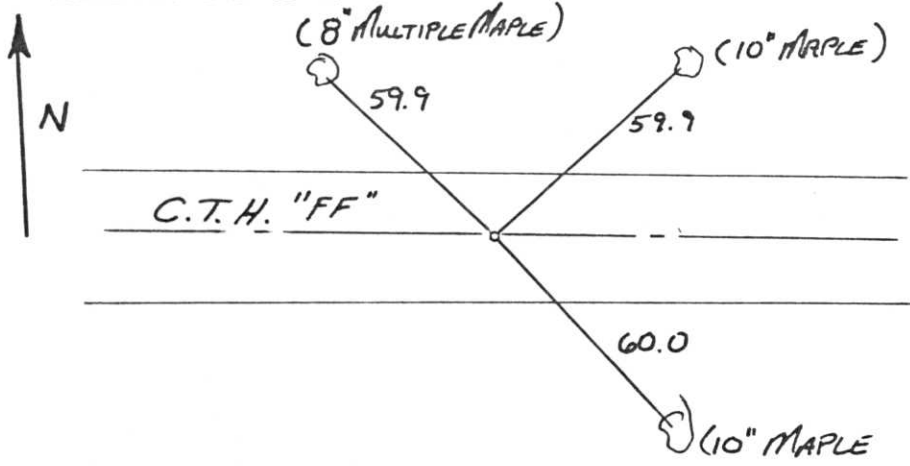

MARATHON COUNTY

SURVEY MONUMENT LOCATION RECORD

SECTION 3
TOWNSHIP 30 - N
RANGE 5 - E

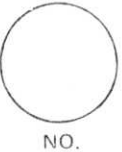

LANDMARK BENCHMARK
CORNER IDENTITY: N 1/4 CORNER

FOUND
SET
RE-SET
RE-TIED

HAMBURG
CITY, VILLAGE, TOWN

STATE PLANE COORDINATE: N: _____


ZONE: _____ E: _____

ELEVATION - (FEET): _____ DATUM: _____

BETA ANGLE: _____ WEATHER: _____

DATE OF SURVEY: 11-16-78 TEMPERATURE: _____ °F

SURVEY PARTY: RKF, R.W.

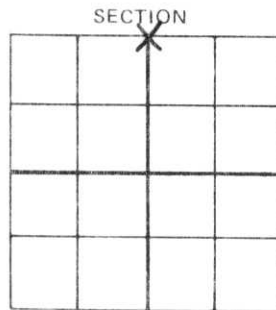

LOCATION
(Indicated By X)



BASIS FOR MONUMENT LOCATION:

DESCRIBE METHOD OF SURVEY AND CORNER AUTHENTICATION

*Found square cut granite
stone 1' below surface,
24.75 feet from woven
wire for fence
north*

SEAL

*32
Sec ~~31~~-31-5 (S 1/4 cr)*



FIELD BOOK NO. "FF" PAGE NO. _____

COMPANY MARATHON CO. HWY.


CERTIFIED CORRECT:

Robert K Fergal

DATE: Nov 12, 1979 Registered Land Surveyor

TIE SKETCH:

SHOW MINIMUM OF THREE (3) HORIZONTAL TIE DISTANCES TO FIXED WITNESS MONUMENTS.
DESCRIBE ALL MONUMENTS FOUND OR SET. CORRECT ALL DISTANCES SHOWN TO STANDARD
TEMPERATURE OF 68° F.

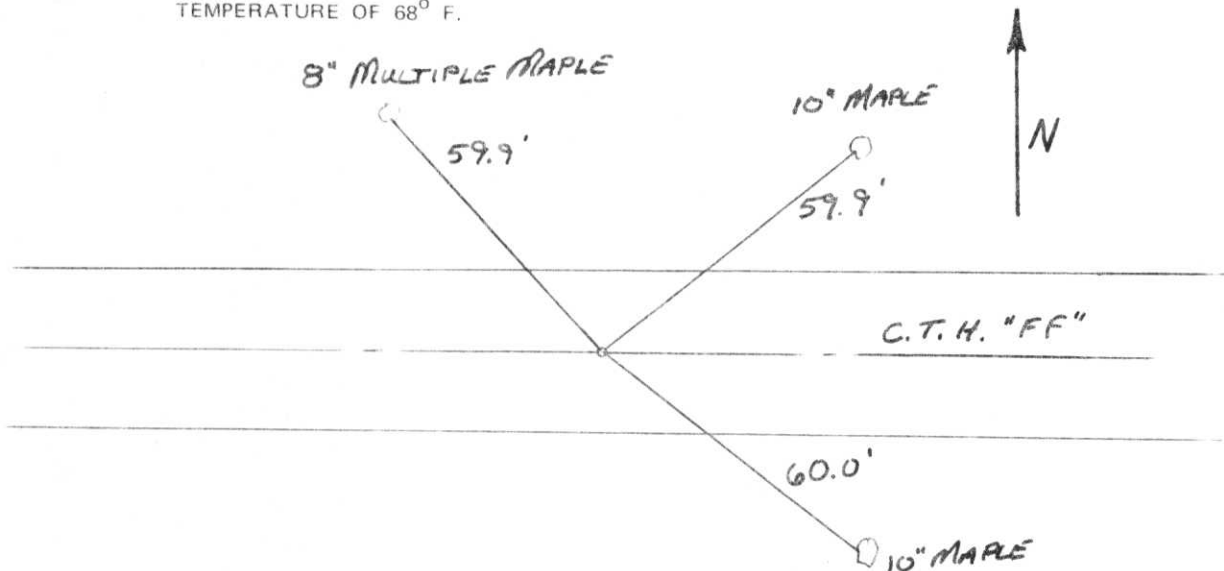

CERTIFIED LAND CORNER RESTORATION

Index No. Y-5,6

State of Wisconsin }
County of LINCOLN } ss.

History of original corner establishment:

I FRANCIS X. FOX, do hereby certify that on the _____ day of _____, 19 71, I found NO evidence of the NORTH 1/4 corner of SECTION 2 Township 30, North, Range 5 EAST, Fourth, Principal Meridian, as described hereon; and that from this evidence I established a new monument and accessories as described hereon to perpetuate the original location of this corner.

Description of corner evidence found:

NONE


Resident witnesses:

Description of monument and accessories I established to perpetuate the original location of this corner.

DID NOT RELOCATE

DID EXTENSIVE DIGGING WITH BACKHOE

26.

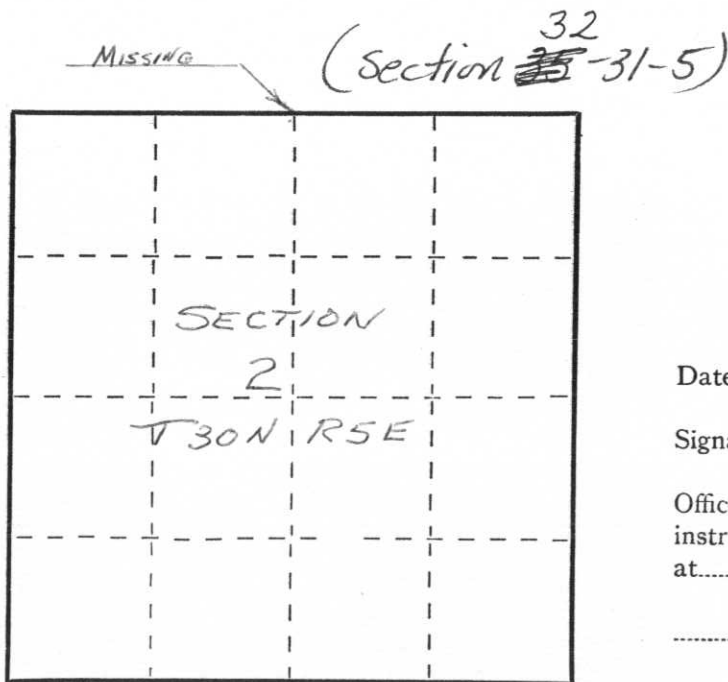

Dated at MERRILL, Wis., this 6TH day of DECEMBER, 19 72.

Signature Francis X. Fox Title HIGHWAY COMMISSIONER Registration No. S-0046
(County Surveyor, Registered Land Surveyor, or other duly authorized official)

Office of Register of Deeds, County of _____, I hereby certify that the within instrument was filed in this office for record on the _____ day of _____, 19 _____ at _____ o'clock _____ M.

(Register of Deeds)

By _____ Deputy

○ = Corner monument restored.

MARATHON COUNTY U.S. PUBLIC LAND SURVEY MONUMENT LOCATION RECORD


SECTION 3
TOWNSHIP 30
RANGE 5

8
NO.

LANDMARK BENCHMARK _____
CORNER IDENTITY: N¹/₄ Cor; Railroad Spike
STATE PLANE COORDINATE: N: _____
ZONE: _____ E: _____
ELEVATION - (FEET): _____ DATUM: _____
THETA ANGLE: _____ WEATHER: _____
DATE OF SURVEY: 1-30-86 TEMPERATURE: _____ °F
SURVEY PARTY: Nowaczyk, Krueger

FOUND
SET
RE-SET
RE-TIED


Hamburg
VILLAGE, TOWN

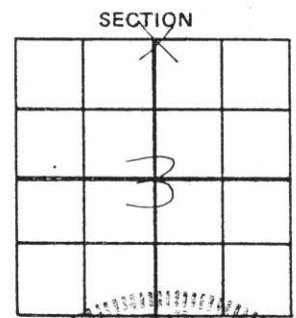

BASIS FOR MONUMENT LOCATION: (DESCRIBE METHOD OF SURVEY AND CORNER AUTHENTICATION)

Re-tied corner because of the need to update. Found existing railroad spike that fit remaining ties. Added new ties. Had been tied by Fergot in 1979.


SEAL

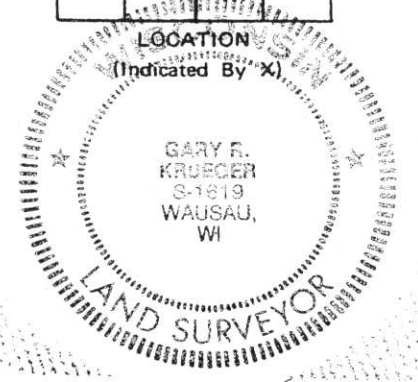

CERTIFIED CORRECT:
Gary R. Krueger
Gary R. Krueger RLS NO. 1619
Registered Land Surveyor
DATE: 1-31-86

FIELD BOOK NO. _____ PAGE NO. _____
COMPANY Surveying Specialists

TIE SKETCH: SHOW MINIMUM OF FOUR (4) HORIZONTAL TIE DISTANCES TO FIXED WITNESS MONUMENTS. DESCRIBE ALL MONUMENTS FOUND OR SET. CORRECT ALL DISTANCES SHOWN TO STANDARD TEMPERATURE OF 68° F.

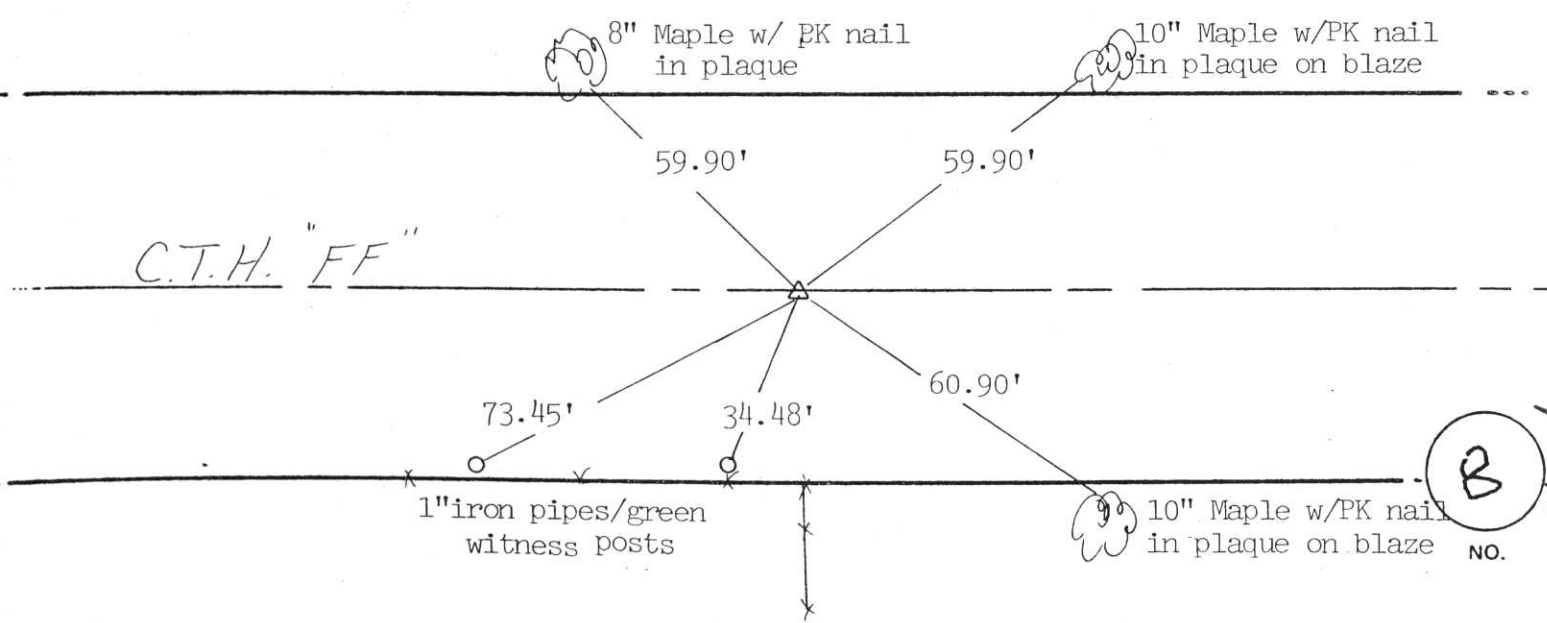

C.T.H. "FF"

8
1-516
NO.