

CERTIFIED LAND CORNER RESTORATION


Index No. C-21

State of Wisconsin }
County of Lincoln } ss.

I Sheridan D. Schwark, do hereby certify that on the 12th day of April, 19 78, I found evidence of the East one-quarter corner of Section 2 Township 31, North, Range 6 East, Fourth, Principal Meridian, as described hereon; and that from this evidence I established a new monument and accessories as described hereon to perpetuate the original location of this corner.

Resident witnesses:

.....
.....
.....

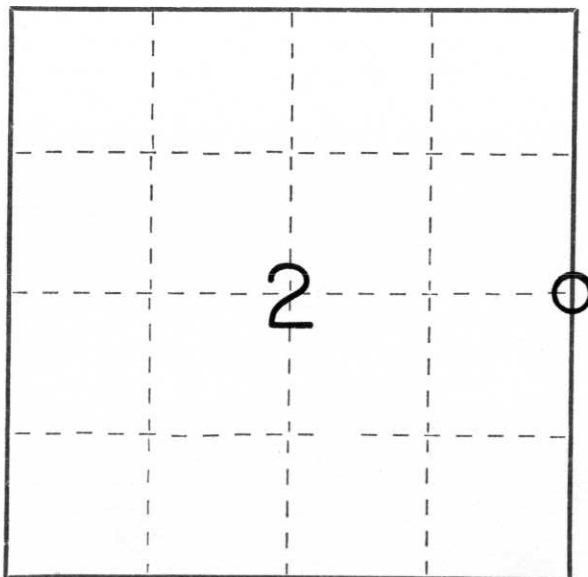

○ = Corner monument restored.

History of original corner establishment:

Date: March, 1852
Surveyor: A.G. & F.S. Ellis
Monument: Wood post
Witnesses: 12" Birch N60°E 10 links
14" " S75°W 36 links

Description of corner evidence found:

After checking with the Highway Dept. and finding there was no evidence of a corner when C.T.H. "K" was rebuilt in 1971, I decided to use an existing P.K. which was found in the centerline of the road, on line with a fence to the west. This nail was set by the Highway Dept. and has also been used by several previous surveyors in the area.

Description of monument and accessories I established to perpetuate the original location of this corner.

We set a Lincoln County Berntsen monument with the following witness monuments:
1 1/4" x 30" iron pipe set 3' east of power pole No. 3106-2R12 bearing, West, 45.71
1 1/4" x 30" iron pipe set 3' west of power pole No. 3106-1L10 bearing, East, 42.95
1 1/4" x 30" iron pipe set in centerline of C.T.H. "K" South, 55.93'
1 1/4" x 30" iron pipe set in centerline of C.T.H. "K" North, 62.92'

Dated at Merrill, Wis., this 14th day of April, 19 78.

Signature Sheridan Schwark Title Registered Land Surveyor Registration No. S-1205
(County Surveyor, Registered Land Surveyor, or other duly authorized official)

Office of Register of Deeds, County of _____, I hereby certify that the within instrument was filed in this office for record on the _____ day of _____, 19 _____ at _____ o'clock _____ M.

.....
(Register of Deeds)

By _____ Deputy



25 1:49 PM



25 1:50 PM



25 1:51 PM