

CERTIFIED LAND CORNER RESTORATION

Index No. E-5

State of Wisconsin }
County of Lincoln } ss.

History of original corner establishment:

Wood post set by original Government Surveyor.



I, Sheridan D. Schwark, do hereby certify that on the 30th day of October, 1980, I found evidence of the Southwest corner of Section 5 Township 31, North, Range 6 East, Fourth, Principal Meridian, as described hereon; and that from this evidence I established a new monument and accessories as described hereon to perpetuate the original location of this corner.

Description of corner evidence found:


We found a 6" x 6" red granite monument with its top approximately 6" above grade. The stone fits the centerline - centerline of Sunset Drive well. We set a 3/4" x 24" solid round iron rod on the East side of the stone. The stone was set by Louis Kleinschmidt (Land Surveyor) in a 1903 resurvey. His resurvey is recorded in the Register of Deeds office.

Resident witnesses:

.....
.....
.....

Description of monument and accessories I established to perpetuate the original location of this corner.

NOTE: All ties are P.K. nails set in trees.

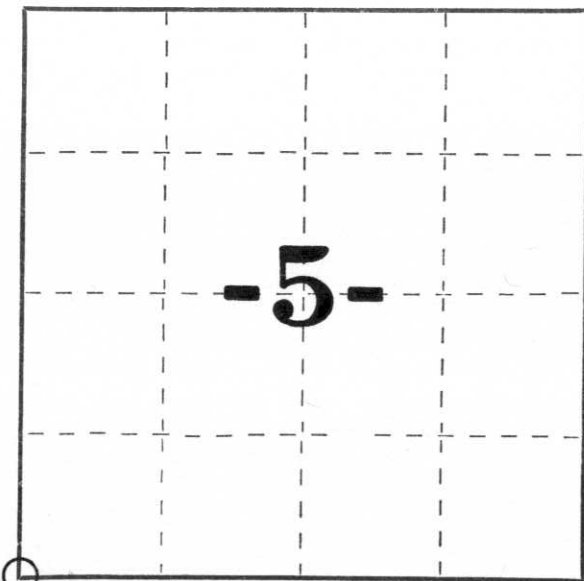

○ = Corner monument restored.

4" Double Maples
N21°W, 4.92'

S 12°W, 38.27'
8" Double Oaks



S32°E, 46.13'
5" Maple



9	5
7	8

Dated at Merrill, Wis., this 26th day of November, 1980.

Signature Sheridan D. Schwark Title Registered Land Surveyor Registration No. S-1205
(County Surveyor, Registered Land Surveyor, or other duly authorized official)

Office of Register of Deeds, County of _____, I hereby certify that the within instrument was filed in this office for record on the _____ day of _____, 19____ at _____ o'clock _____ M.

.....
(Register of Deeds)

By _____ Deputy