

CERTIFIED LAND CORNER RESTORATION

Index No. E-17

State of Wisconsin }
County of Lincoln } ss.

History of original corner establishment:

I Sheridan D. Schwark, do hereby certify that on the 11th day of April, 1977, I found evidence of the Southeast Section corner of Section 3 Township 31, North, Range 6 East, Fourth, Principal Meridian, as described hereon; and that from this evidence I established a new monument and accessories as described hereon to perpetuate the original location of this corner.

Date: April 29, 1852
Surveyor: Albert & Frederick Ellis
Monument: Wood post
Witnesses: 8" Hemlock N12°W, 26L
16" Elm S34°E, 26L

Description of corner evidence found:


Found 6" x 6" stone monument with drill hole flush with surface of gravel road. No bearing trees found.

Resident witnesses:
.....
.....
.....

Description of monument and accessories I established to perpetuate the original location of this corner.

Witnessed stone monument as follows:

- 3/4" x 30" solid round iron rod, + 1' south of P.P.#C-81, bearing N51°E, 47.10'
- 3/4" x 30" solid round iron rod, + 1' north of a 10" Red Pine, bearing S61°E, 54.60'
- 3/4" x 30" solid round iron rod, + 1' east of P.P.#54-32, bearing S51°W, 35.00'
- 3/4" x 30" solid round iron rod, + 1' east of street sign, bearing N41°W, 35.60'

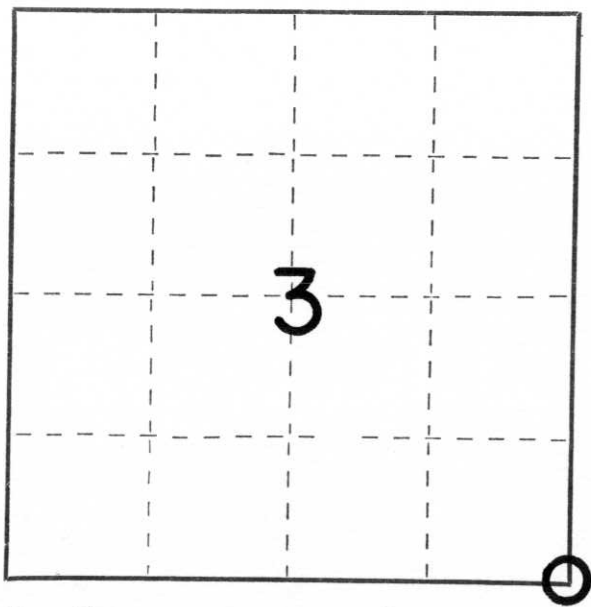

○ = Corner monument restored.

Dated at Merrill, Wis., this 8th day of July, 1977.

Signature Sheridan D. Schwark Title Registered Land Surveyor Registration No. S-1205
(County Surveyor, Registered Land Surveyor, or other duly authorized official)

Office of Register of Deeds, County of....., I hereby certify that the within instrument was filed in this office for record on the..... day of....., 19..... at..... o'clock..... M.

.....
(Register of Deeds)
By..... Deputy



25 2:41PM



25 2:42 PM



25 2:44 PM