

U.S. PUBLIC LAND SURVEY MONUMENT RECORD


Note: This form is intended and designed to fulfill all requirements of Wisconsin Administrative Code, Chapter A-E 5.02, U.S. Public Land Survey Monument Record (3) (a) (b) (c) (d) (e) (f) (g) (h) (i). An additional sheet may be added if necessary to conform with said requirements.

(a) Corner location: Township 31 North

Range 6 East

Town/City/Village MERRILL

County Lincoln

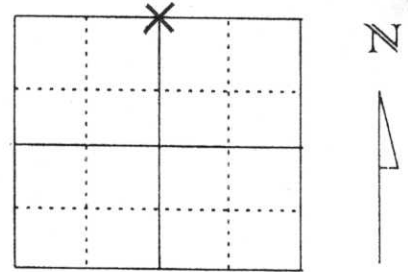

Section 14

(b) (f) (g) (h) Description of monument found at this corner and if it was accepted, state all evidence (material, testimonial, occupational, plats, records, other monuments) used as a basis for accepting. If not accepted or if nothing was found, state evidence used as basis for establishing location. If reestablished through lost corner proportionate methods, indicate all monuments, distances and directions used to establish.

IN MARCH OF 1852, F. S. ELLIS SET ¼ POST WITH THE FOLLOWING BEARING TREES: BIRCH 8 N12°E, 22 LINKS AND HEMLOCK 12 S17°E, 49 LINKS. NO OTHER REMONUMENTATION RECORDS WERE FOUND FOR THIS CORNER. WE TIED INTO PROSPECT PARK ADDITION TO THE WEST OF CORNER AND CALCULATED AN APPROXIMATE SEARCH LOCATION IN STANGE KITCHENETTE PARK. WE HAD THE LINCOLN COUNTY HIGHWAY DEPARTMENT DIG AT SEARCH LOCATION WITH TONY DALLMAN, LINCOLN COUNTY SURVEYOR, PRESENT. WE FOUND A 6" X 8" X 26" RED STONE MONUMENT WITH DRILL HOLE IN CENTER DOWN 18 INCHES. ACCEPTED STONE MONUMENT AS NORTH ¼ CORNER AND SET A ½" X 30" RE-BAR ON NORTH SIDE ON STONE MONUMENT. RE-COVERED STONE AND TIED OUT AS SHOWN BELOW.

(c) (d) (e) Plan view of corner with ties to at least 4 witness monuments. If in disagreement with previously established corner, show the distances between the two corners and also indicate the ties to the disputed corner.

(TIE SKETCH ON BACK)

RECEIVED BY LINCOLN COUNTY
SURVEYOR THIS 13TH DAY
OF March 20 06
Tony Dall
COUNTY SURVEYOR

(I) I, DAVID J. GOSLIN

(type or print name) certify that the corner location on this record was determined by me or under my direction and control and that this U.S. Public Land Survey Monument Record is correct and complete to the best of my knowledge and belief.

David J. Goslin
Signature



2-21-06
Date

LEGEND

- EXISTING 1" RE-BAR
- EXISTING STONE MONUMENT
- SET 3/4" X 30" RE-BAR WITH ALUMINUM CAP

