

CERTIFIED LAND CORNER RESTORATION


Index No. Q-23

State of Wisconsin }  
County of Lincoln } ss.

I Sheridan D. Schwark, do hereby certify that on the 15th day of October, 19 80, I found evidence of the South one-quarter corner of Section 24 Township 31, North, Range 6 East, Fourth, Principal Meridian, as described hereon; and that from this evidence I established a new monument and accessories as described hereon to perpetuate the original location of this corner.

Resident witnesses:

.....  
.....  
.....

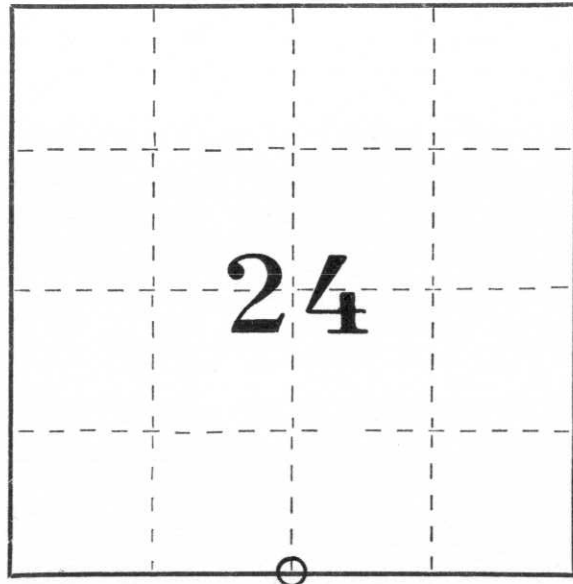

○ = Corner monument restored.


History of original corner establishment:

Wood post by original government surveyor.

Description of corner evidence found:

We found a 6" x 6" granite monument .8' below the surface of the road approximately 1' south of the actual granite roadway.

Description of monument and accessories I established to perpetuate the original location of this corner.

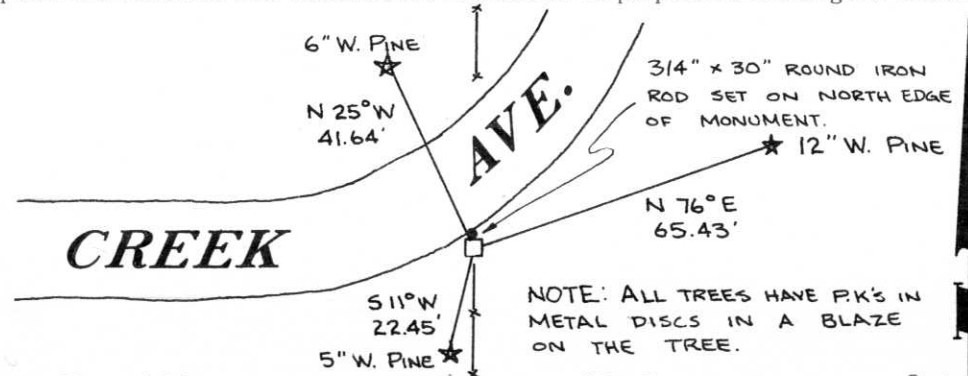

Dated at Merrill, Wis., this 23rd day of October, 19 80.

Signature Sheridan D. Schwark Title Registered Land Surveyor Registration No. S-1205  
(County Surveyor, Registered Land Surveyor, or other duly authorized official)

Office of Register of Deeds, County of....., I hereby certify that the within instrument was filed in this office for record on the.....day of....., 19..... at.....o'clock..... M..

.....  
(Register of Deeds)

By.....Deputy