

CERTIFIED LAND CORNER RESTORATION

Index No. U-5

State of Wisconsin }
County of Lincoln } ss.

History of original corner establishment:

Wood post set by original Government Surveyor.

I, Sheridan D. Schwark, do hereby certify that on the 11th day of November, 1980, I found evidence of the Northwest corner of Section 32 Township 31, North, Range 6 East, Fourth, Principal Meridian, as described hereon; and that from this evidence I established a new monument and accessories as described hereon to perpetuate the original location of this corner.

Description of corner evidence found:


We found a 6" x 6" limestone monument on a fenceline. The stone was approximately 1' above grade and had Section numbers scribed on the sides.

Resident witnesses:


.....
.....
.....



Description of monument and accessories I established to perpetuate the original location of this corner.

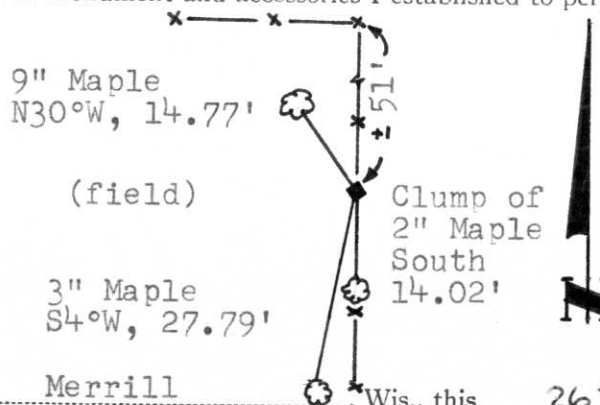

NOTE: All ties are P.K. nails set in blazed trees.

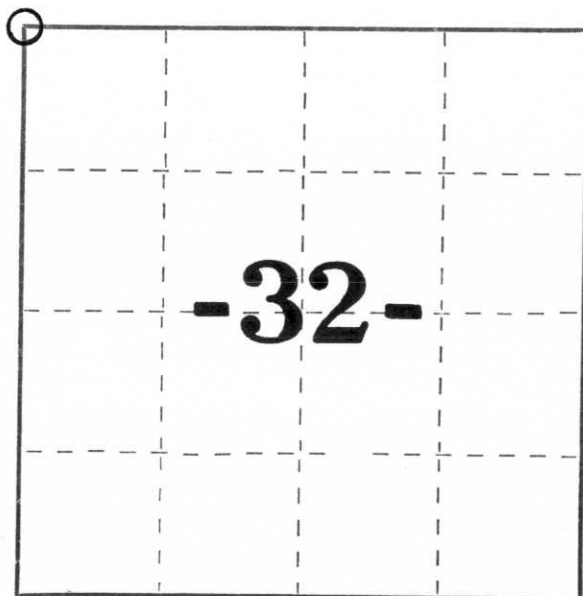

Dated at Merrill, Wis., this 26th day of November, 1980.

Signature Sheridan D. Schwark Title Registered Land Surveyor Registration No. S-1205
(County Surveyor, Registered Land Surveyor, or other duly authorized official)

Office of Register of Deeds, County of _____, I hereby certify that the within instrument was filed in this office for record on the _____ day of _____, 19____ at _____ o'clock _____ M.

(Register of Deeds)

By _____ Deputy

○ = Corner monument restored.