


**MARATHON COUNTY U.S. PUBLIC LAND  
SURVEY MONUMENT LOCATION RECORD**

SECTION 3  
TOWN 30  
RANGE 6  
TOWNSHIP BERLIN

9 I-16  
NO.

LANDMARK     BENCHMARK \_\_\_\_\_  
CORNER IDENTITY: P.K. NAIL SHAFT  
STATE PLANE COORDINATE: N: \_\_\_\_\_  
ZONE: \_\_\_\_\_ E: \_\_\_\_\_  
ELEVATION-(FEET): \_\_\_\_\_ DATUM: \_\_\_\_\_  
THETA ANGLE: \_\_\_\_\_ WEATHER: CLOUDY  
DATE OF SURVEY: 3-30-93 TEMPERATURE: 50 °F  
SURVEY PARTY: MD ES BH

FOUND   
SET   
RE-SET   
RE-TIED

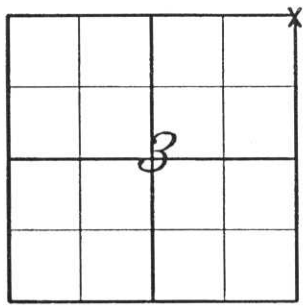

LOCATION  
(Indicated by 'X')



**BASIS FOR MONUMENT LOCATION**  
(DESCRIBE METHOD OF SURVEY AND CORNER AUTHENTICATION)

THIS CORNER WAS PERPETUATED BY CHESTER J. NOWACZYK, S-1143, ON JUNE 6, 1990. SUBSEQUENT TIE SHEET IS ON FILE AT THE MARATHON COUNTY COURTHOUSE.



CERTIFIED CORRECT:  
*M. J. Nordin*  
Registered Land Surveyor  
DATE: 3-30-1993

DRAWN BY: MICHAEL C. REBMAN  
COMPANY: NORDIN & ASSOCIATES, INC.


**TIE SHEET**

SHOW MINIMUM OF FOUR (4) HORIZONTAL TIE DISTANCES TO FIXED WITNESS MONUMENTS. DESCRIBE ALL MONUMENTS FOUND OR SET. CORRECT ALL DISTANCES SHOWN TO STANDARD TEMPERATURE OF 68° F.

**LEGEND AND NOTES**

- ▲ DENOTES GPS POINT
- DENOTES 5/8" x 24" IRON ROD SET
- ⊢ SIGN POST
- DENOTES 3/4" IRON ROD RECOVERED

- A = N62°26'12" E 67.43'
- B = S48°30'51" E 54.37'
- C = S42°07'22" W 64.77'
- D = N55°11'09" W 55.17'
- E = S 1°16'18" E 16.18'

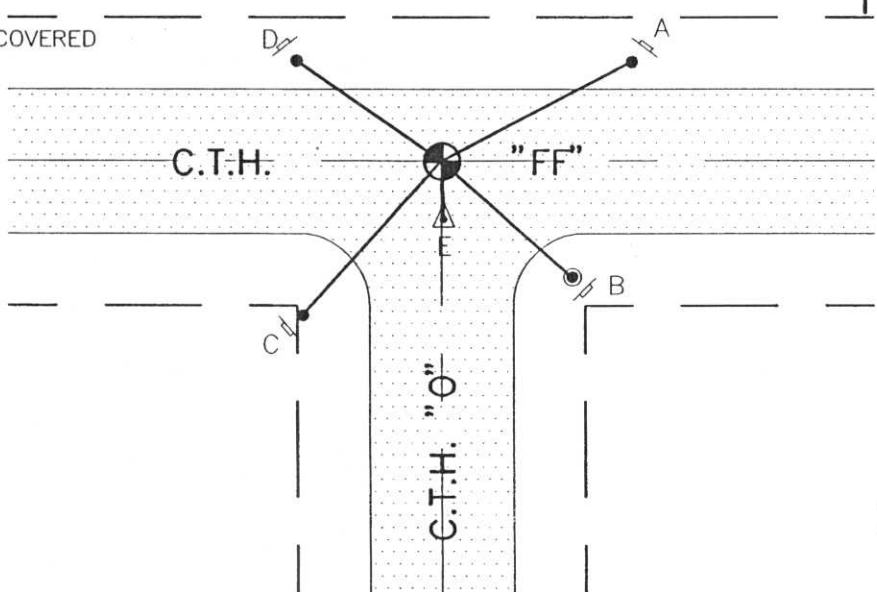

BEARINGS REFERENCED TO MARATHON CO. COORDINATE SYSTEM.

9 I-16  
NO.