

MARATHON COUNTY

SURVEY MONUMENT LOCATION RECORD

SECTION 2
 TOWNSHIP 30 N
 RANGE 7 E
MAINE
 (CITY, VILLAGE, TOWN)

10
 NO.

LANDMARK BENCHMARK FOUND SET
 CORNER IDENTITY: 6"x6" SQUARE SANDSTONE MON. RE-SET
 STATE PLANE COORDINATE: N: _____ RE-TIED
 ZONE: _____ E: _____

ELEVATION -(FEET): _____ DATUM: _____
 THETA ANGLE: _____ WEATHER: SUNNY
 DATE OF SURVEY: FEB 1, 1972 TEMPERATURE: 10 °F
 SURVEY PARTY: ABENDROTH, DENZINE, MOSHER



LOCATION
 (INDICATED BY X)

BASIS FOR MONUMENT LOCATION:

(DESCRIBE METHOD OF SURVEY AND CORNER AUTHENTICATION)

FOUND 6"x6" SANDSTONE MONUMENT IN PLACE SEAL
 JUST SOUTH OF EAST-WEST FENCE LINE. THIS
 MONUMENT IS THE NORTH 1/4 CORNER OF SECTION
 2-30-7 (MARATHON COUNTY).


A 6"x6" SQUARE RED GRANITE STONE INSCRIBED
 "S 1/4" WAS FOUND IN FENCE INTERSECTION 78.20
 FEET WEST OF SANDSTONE MONUMENT. THIS MON-
 UMENT IS THE SOUTH 1/4 CORNER OF
 SECTION 32-31-7 (LINCOLN COUNTY).



CERTIFIED CORRECT:
Edwin R. Abendroth
 5-798
 REGISTERED LAND SURVEYOR
 DATE: FEB 8, 1972

TIE SKETCH:

SHOW MINIMUM OF THREE (3) HORIZONTAL TIE DISTANCES TO FIXED WITNESS MONUMENTS. DESCRIBE ALL MONUMENTS FOUND OR SET. CORRECT ALL DISTANCES SHOWN TO STANDARD TEMPERATURE OF 68° F.

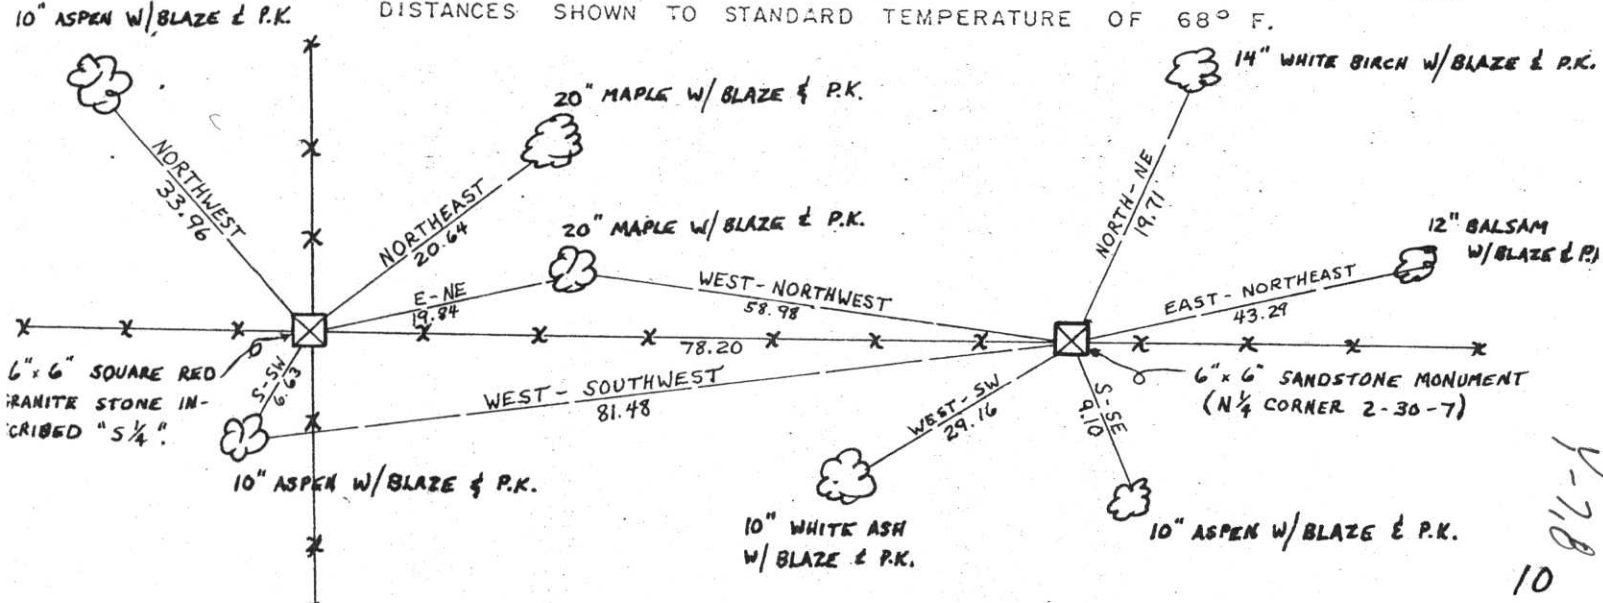

4-78
 10