

MARATHON COUNTY

SURVEY MONUMENT LOCATION RECORD

SECTION 1  
TOWNSHIP 30  
RANGE 7

13  
NO.

LANDMARK  BENCHMARK

FOUND   
SET   
RE-SET   
RE-TIED

CORNER IDENTITY: 6" Square Granite Stone

STATE PLANE COORDINATE: N: \_\_\_\_\_

ZONE: \_\_\_\_\_ E: \_\_\_\_\_


ELEVATION - (FEET): \_\_\_\_\_ DATUM: \_\_\_\_\_

THETA ANGLE: \_\_\_\_\_ WEATHER: Cloudy

DATE OF SURVEY: October 30, 81 TEMPERATURE: 50 °F

SURVEY PARTY: L. Mosher, A. Povilaitis

TEXAS  
CITY, VILLAGE, TOWN \_\_\_\_\_

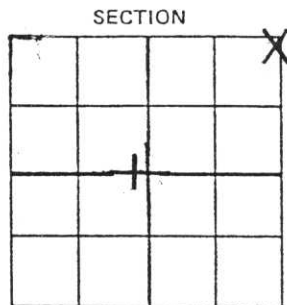

SECTION  
LOCATION  
(Indicated By X)

NO.



BASIS FOR MONUMENT LOCATION:

(DESCRIBE METHOD OF SURVEY AND CORNER AUTHENTICATION)

NORTHWEST CORNER SECTION 6-30-8.

SEAL

Recovered intact a 6" square Red Granite Stone Monument With cross. Monument is located 2 feet North of fence corner and is flush with the ground surface.

SOUTHEAST CORNER SECTION 33-31-7.

Recovered intact a 6" square Red Granite Stone Monument marked 33/34 on top of stone which is flush with the ground surface.

CERTIFIED CORRECT:

LaVerne H. Mosher


Registered Land Surveyor

DATE: November 2, 1981



TIE SKETCH:

SHOW MINIMUM OF THREE (3) HORIZONTAL TIE DISTANCES TO FIXED WITNESS MONUMENTS. DESCRIBE ALL MONUMENTS FOUND OR SET. CORRECT ALL DISTANCES SHOWN TO STANDARD TEMPERATURE OF 68° F.

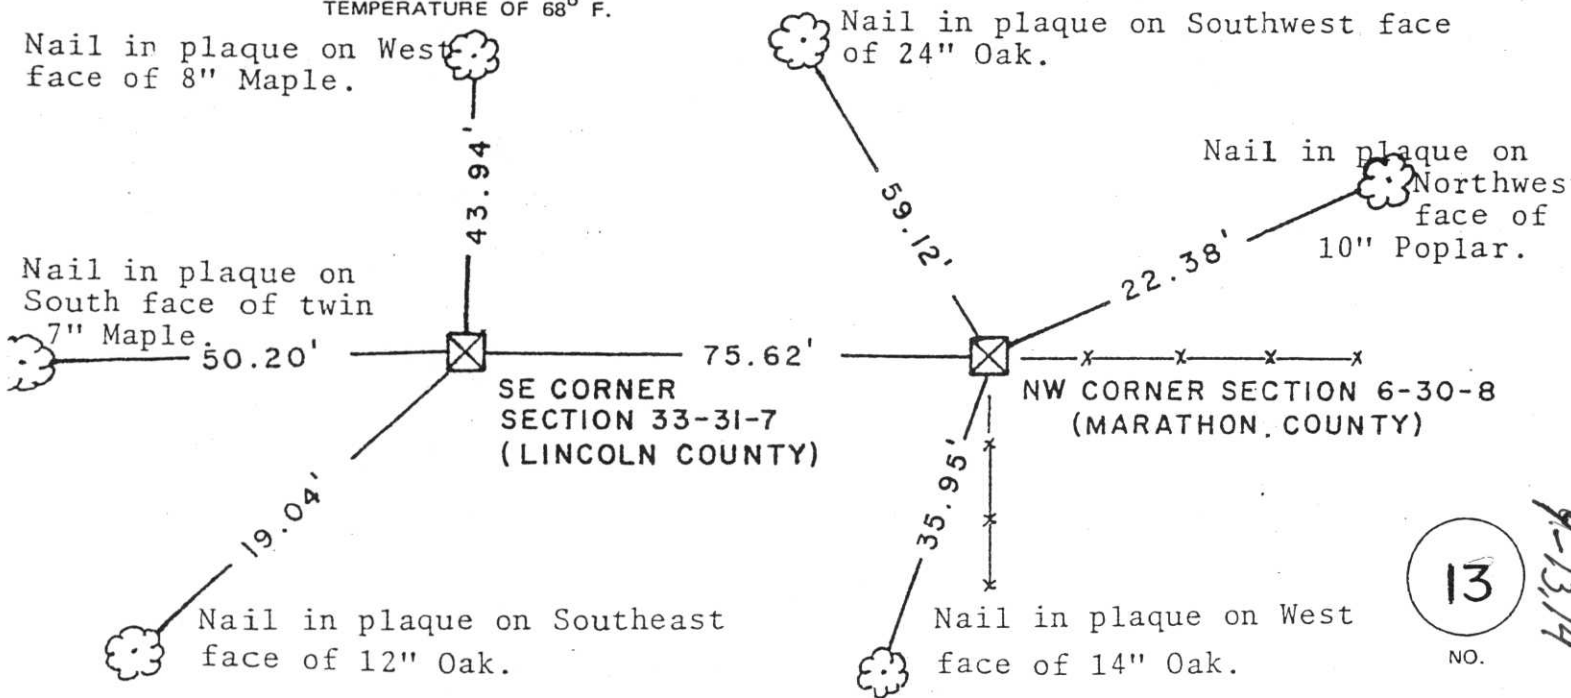

13  
NO.

H-13/14