

MARATHON COUNTY

SURVEY MONUMENT LOCATION RECORD

SECTION 6
TOWNSHIP 30
RANGE 8

2
NO.

LANDMARK BENCHMARK FOUND
CORNER IDENTITY: 6" Square Granite Stone SET
STATE PLANE COORDINATE: N: _____ RE - SET
ZONE: _____ E: _____ RE - TIED


ELEVATION - (FEET): _____ DATUM: _____

THETA ANGLE: _____ WEATHER: Cloudy

DATE OF SURVEY: Oct. 30, 1981 TEMPERATURE: 50 °F

SURVEY PARTY: L. Mosher, A. Povilaitis

TEXAS
CITY, VILLAGE, TOWN

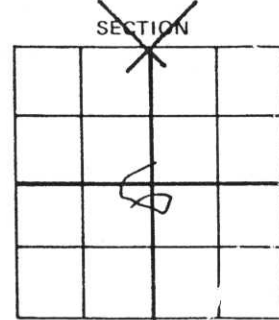

LOCATION
(Indicated By X)



BASIS FOR MONUMENT LOCATION:

(DESCRIBE METHOD OF SURVEY AND CORNER AUTHENTICATION)

Recovered 6" square Red Granite stone monument with cross intact on old East-West fence line. Corner is located about 30 feet North of open field.




CERTIFIED CORRECT:
LaVerne H. Mosher

Registered Land Surveyor
DATE: November 7, 1981

FIELD BOOK NO. _____ PAGE NO. _____
COMPANY LHM Surveying

TIE SKETCH: SHOW MINIMUM OF THREE (3) HORIZONTAL TIE DISTANCES TO FIXED WITNESS MONUMENTS. DESCRIBE ALL MONUMENTS FOUND OR SET. CORRECT ALL DISTANCES SHOWN TO STANDARD TEMPERATURE OF 68° F.

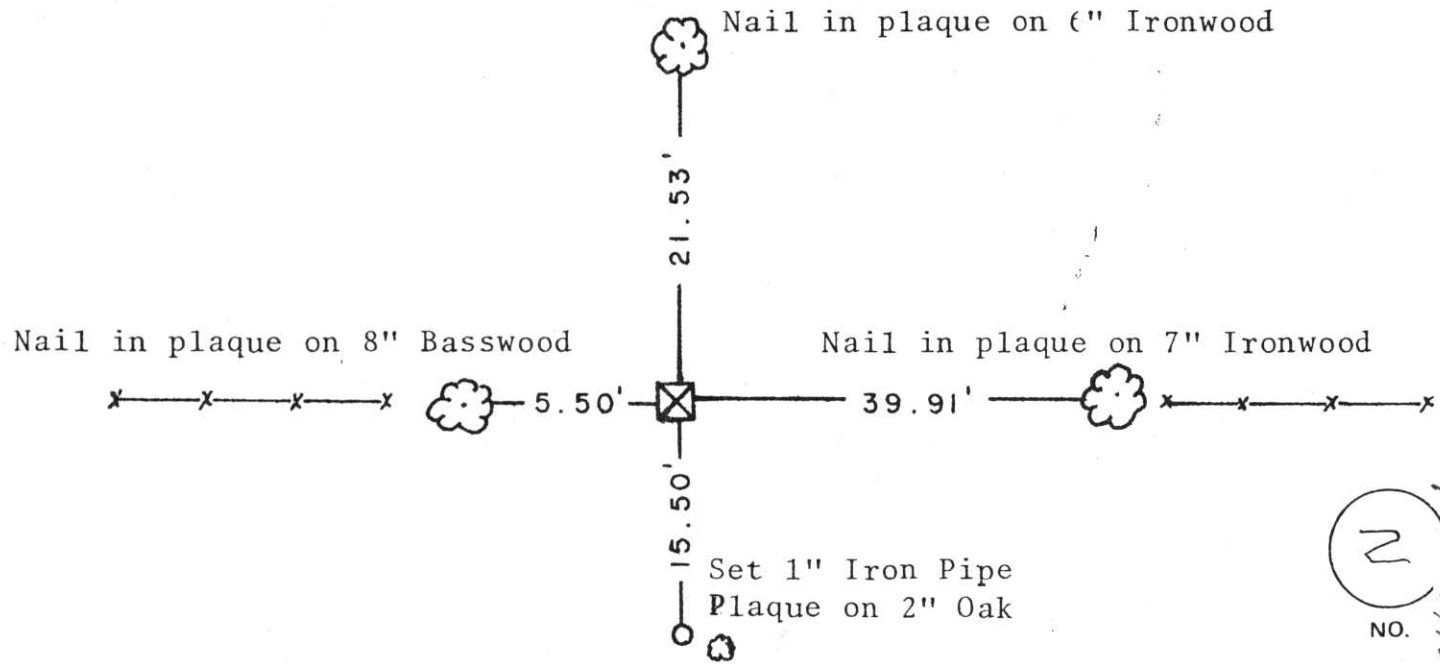

2
NO.
51161-1