


CERTIFIED LAND CORNER RESTORATION

Index No. W-9

State of Wisconsin }
County of LINCOLN } ss.

I LA VERNE H. MOSHER, do hereby certify that on the 16TH day of MARCH, 1983, I found evidence of the EAST 1/4 corner of SECTION 32 Township 31, North, Range 8 EAST, Fourth, Principal Meridian, as described hereon; and that from this evidence I established a new monument and accessories as described hereon to perpetuate the original location of this corner.

Resident witnesses:

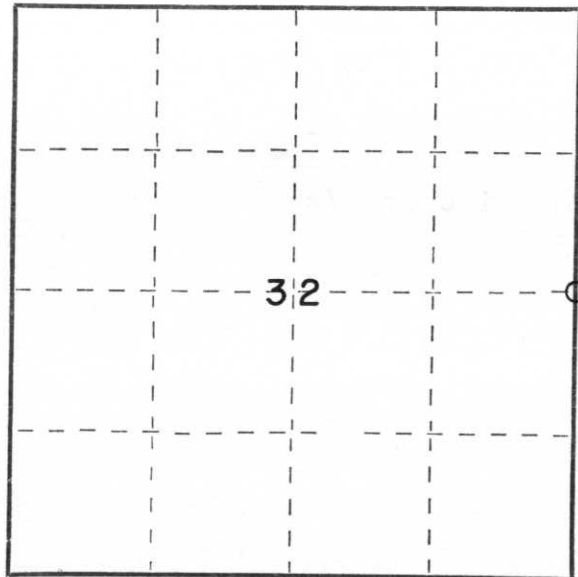

○ = Corner monument restored.

History of original corner establishment:

Original U.S. government survey conducted in year 1852-53 with wooden posts set for section and quarter corners. Subsequently, 6"x6"x36" red granite stone monuments were set during a remonumentation survey of later date (year unknown).

Description of corner evidence found:

Recovered a 6"x6" granite stone with cross about 10 inches below roadway surface. Set a 3/4"x7" rebar atop center of stone to aid future location.

Description of monument and accessories I established to perpetuate the original location of this corner.

3/4" iron rebar over 6" square red granite stone

NE 36.30' Set 1"x24" iron pipe at North edge of rock pile

SE 40.97' Set 1"x24" iron pipe at R/W

SW 54.57' Nail in aluminum plaque on power pole

WNW 24.27' Set 1"x24" iron pipe at back of ditch, 12' North of centerline of driveway

(See sketch on reverse)

Dated at Schofield, Wis., this 18th day of March, 1983.

Signature LaVerne H. Mosher Title Reg. Land Surveyor Registration No. S-1188
(County Surveyor, Registered Land Surveyor, or other duly authorized official)

Office of Register of Deeds, County of _____, I hereby certify that the within instrument was filed in this office for record on the _____ day of _____, 19____ at _____ o'clock _____ M.

(Register of Deeds)

By _____ Deputy



RECEIVED AT LINCOLN COUNTY
COURTHOUSE THIS 13 DAY
OF Sept 1983.
Bob Grisham
TAX DESCRIPTION OFFICE

