

MARATHON COUNTY

SURVEY MONUMENT LOCATION RECORD


SECTION 3
TOWNSHIP 30
RANGE 8

8
NO.

LANDMARK BENCHMARK FOUND
CORNER IDENTITY: 6"X6" Stone Monument SET
RE-SET
RE-TIED

Texas
CITY, VILLAGE, TOWN

STATE PLANE COORDINATE: N: _____
ZONE: _____ E: _____
ELEVATION - (FEET): _____ DATUM: _____
THETA ANGLE: _____ WEATHER: Partly Cloudy
DATE OF SURVEY: 6/20/80 TEMPERATURE: 65 °F
SURVEY PARTY: Nowaczyk, Krueger

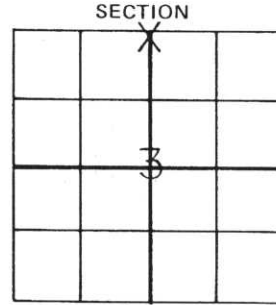

BASIS FOR MONUMENT LOCATION:

(DESCRIBE METHOD OF SURVEY AND CORNER AUTHENTICATION)

Dug aNd Found Stone, placed
Bernsten over top.

SEAL




CERTIFIED CORRECT

Guyton J. Nowaczyk
5-1143
Registered Land Surveyor
DATE: June 27, 1980

Texas
FIELD BOOK NO. Maine PAGE NO. 11
COMPANY Wisconsin Valley Surveyors

TIE SKETCH:

SHOW MINIMUM OF THREE (3) HORIZONTAL TIE DISTANCES TO FIXED WITNESS MONUMENTS.
DESCRIBE ALL MONUMENTS FOUND OR SET. CORRECT ALL DISTANCES SHOWN TO STANDARD
TEMPERATURE OF 68° F.

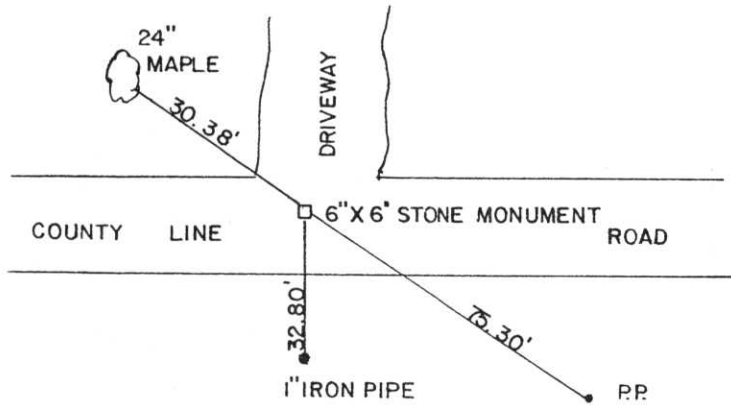

1-2,3
8
NO.