

LINCOLN COUNTY U.S. PUBLIC LAND TIE SHEET RECORD

SECTION 14
TOWNSHIP 32N
RANGE 4 E

143242
NO.

CORNING
CITY, VILLAGE, TOWN

LANDMARK

CORNER INDENTITY: 1.5" IRON PIPE


LINCOLN COUNTY COORDINATE: N: 153615.543

E: 324875.029

DATE OF SURVEY: October 23, 2007

SURVEY PARTY: Eron/Nieds

FOUND
SET
RE-SET
RE-TIED

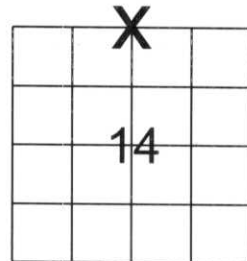


SECTION

Description of monument found at this corner and if was accepted, state all evidence (material, testimonial, occupational, plats, records, other monuments) used as a basis for accepting. If not accepted or if nothing was found, state evidence used as basis for establishing location. If reestablished through lost corner proportionate methods, indicate all monuments, distances and directions used to establish.

BASIS FOR MONUMENT LOCATION:

(DESCRIBE METHOD OF SURVEY AND CORNER AUTHENTICATION)

Found 1.5" iron pipe at corner. Blaze trees, and comparison to original notes supports the iron pipe as the corner.

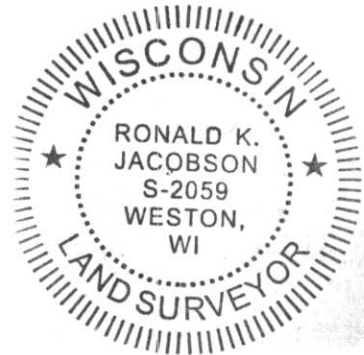

CWE, Inc.

5707 SCHOFIELD AVE.
WESTON, WISCONSIN
54476

PHONE: (715) 359-9400
FAX: (715) 355-4199

general@cwengineers.com
www.cwengineers.com

RECEIVED BY LINCOLN COUNTY
SURVEYOR THIS 2ND DAY
OF November 20 07
Tony Dahl
COUNTY SURVEYOR

CERTIFIED CORRECT:

Ronald K. Jacobson
Ronald Jacobson RLS 2059-008

Registered Land Surveyor

DATE: November 2, 2007

TIE SKETCH:

SHOW MINIMUM OF FOUR (4) HORIZONTAL TIE DISTANCES TO FIXED WITNESS MONUMENTS.
DESCRIBE ALL MONUMENTS FOUND OR SET. ALL DISTANCES SHOWN IN US SURVEY FEET.

