

LINCOLN COUNTY U.S. PUBLIC LAND TIE SHEET RECORD

SECTION 32
TOWNSHIP 32N
RANGE 4 E

323243
NO.

LANDMARK


CORNING
CITY, VILLAGE, TOWN

CORNER INDENTITY: SURVEY NAIL

LINCOLN COUNTY COORDINATE: N: 138095.2871
E: 311238.9056

DATE OF SURVEY: March 26, 2007
SURVEY PARTY: Rehfeldt/Dahlvig

FOUND
SET
RE-SET
RE-TIED

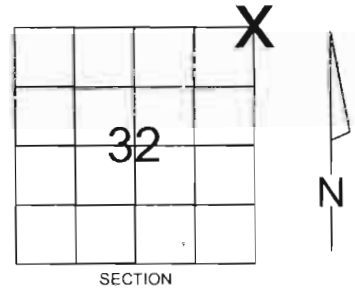

Description of monument found at this corner and if was accepted, state all evidence (material, testimonial, occupational, plats, records, other monuments) used as a basis for accepting. If not accepted or if nothing was found, state evidence used as basis for establishing location. If reestablished through lost corner proportionate methods, indicate all monuments, distances and directions used to establish.

BASIS FOR MONUMENT LOCATION:

(DESCRIBE METHOD OF SURVEY AND CORNER AUTHENTICATION)

Survey nail was set based on evidence surveyed for C.T.H. M and the right-of-way plat for C.T.H. M. Conversations with the Lincoln County and Taylor County Surveyors confirmed the location of the corner.



CERTIFIED CORRECT:

[Signature]

Ronald Jacobson RLS 2059-008


Registered Land Surveyor

DATE: March 29, 2007

COMPANY: Central Wisconsin Engineers & Architects
5707 Schofield Ave.
Weston, Wisconsin 54476
(715) 359-9400

TIE SKETCH:

SHOW MINIMUM OF FOUR (4) HORIZONTAL TIE DISTANCES TO FIXED WITNESS MONUMENTS.
DESCRIBE ALL MONUMENTS FOUND OR SET. ALL DISTANCES SHOWN IN US SURVEY FEET.

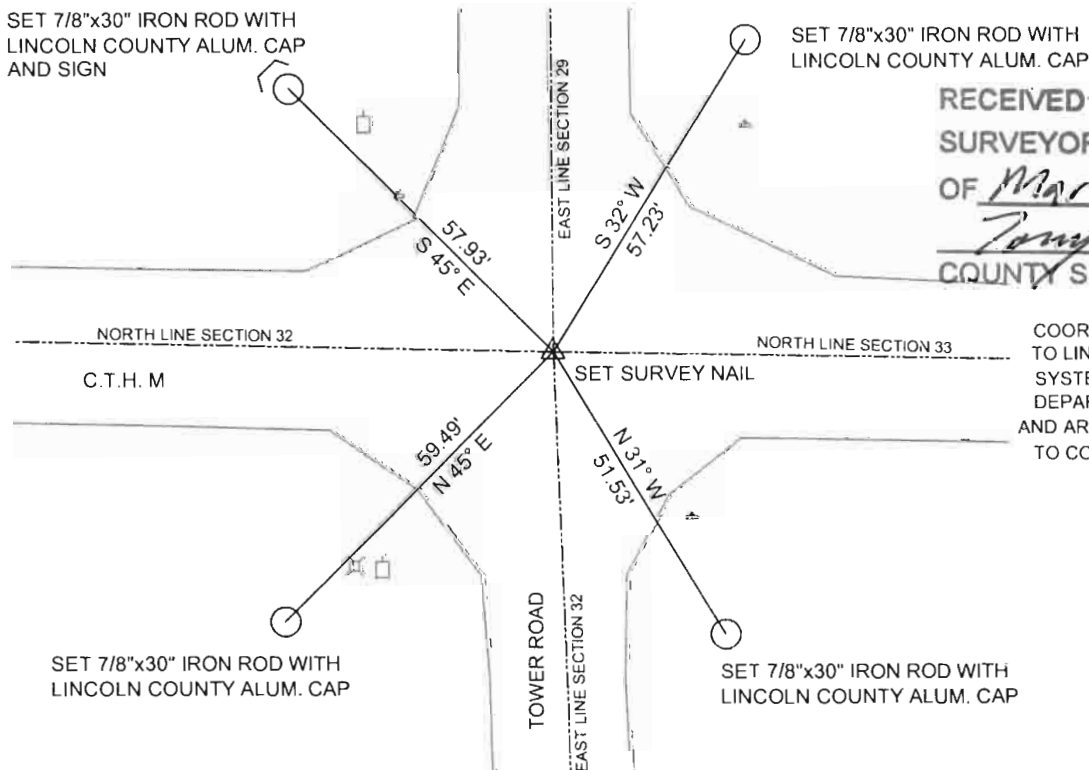

RECEIVED BY LINCOLN COUNTY
SURVEYOR THIS 29TH DAY
OF March 2007
[Signature]
COUNTY SURVEYOR

COORDINATES ARE REFERENCED TO LINCOLN COUNTY COORDINATE SYSTEM AS DEVELOPED BY THE WI. DEPARTMENT OF TRANSPORTATION AND ARE BASED ON GPS OBSERVATIONS TO CONTROL POINTS AS SUPPLIED BY LINCOLN COUNTY.




NOT TO SCALE
BEARINGS REFERENCED TO MAGNETIC NORTH

21-9

U.S. PUBLIC LAND SURVEY MONUMENT RECORD

Note: This form is intended and designed to fulfill all requirements of Wisconsin Administrative Code, Chapter A-E 5.02, U.S. Public Land Survey Monument Record (3) (a) (b) (c) (d) (e) (f) (g) (h) (i). An additional sheet may be added if necessary to conform with said requirements.

(a) Corner location: Township 32 North
Range 4 East
Town/City/Village TN. OF CORNING
County Lincoln

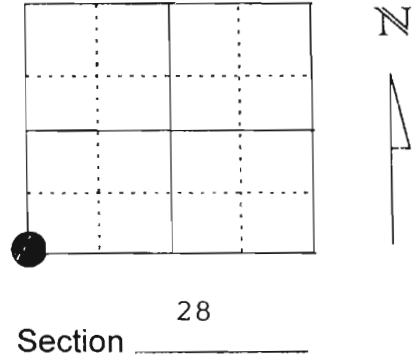


(b) (f) (g) (h) Description of monument found at this corner and if it was accepted, state all evidence (material, testimonial, occupational, plats, records, other monuments) used as a basis for accepting. If not accepted or if nothing was found, state evidence used as basis for establishing location. If reestablished through lost corner proportionate methods, indicate all monuments, distances and directions used to establish.

EXCAVATED C/L C/L HWY. "M" & TOWER RD. FOUND NO EVIDENCE OF CORNER LOCATION ABOVE OR BELOW GROUND

(c) (d) (e) Plan view of corner with ties to at least 4 witness monuments. If in disagreement with previously established corner, show the distances between the two corners and also indicate the ties to the disputed corner.

RECEIVED AT LINCOLN COUNTY
COURTHOUSE THIS 7th DAY
OF April 19 98
David Lemke
TAX DESCRIPTION OFFICE

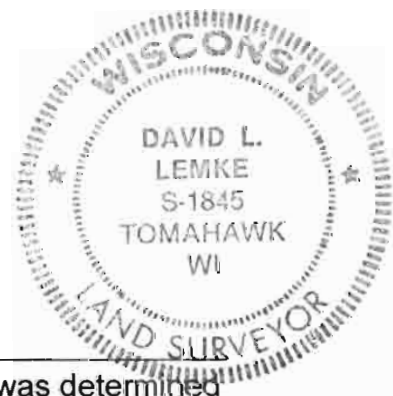

DAVID L. LEMKE S-1845

(I) I, _____
(type or print name) certify that the corner location on this record was determined by me or under my direction and control and that this U.S. Public Land Survey Monument Record is correct and complete to the best of my knowledge and belief.

David Lemke
Signature

MAR. 30 1998

Date









