

CERTIFIED LAND CORNER RESTORATION

Index No. E-17

State of Wisconsin }
County of Lincoln } ss.

History of original corner establishment:

NOTES NOT AVAILABLE.

I Sheridan D. Schwark, do hereby certify that on the 18th day of April, 1978, I found evidence of the Northwest corner of Section 11 Township 32, North, Range 5 East, Fourth, Principal Meridian, as described hereon; and that from this evidence I established a new monument and accessories as described hereon to perpetuate the original location of this corner.

Description of corner evidence found:

We found a 1" iron pipe which local resident David Ament said was set by Francis Fox. (Registered Land Surveyor)


Resident witnesses:

.....
.....
.....

Description of monument and accessories I established to perpetuate the original location of this corner.

We set a Lincoln County Berntsen monument with the following witness monuments:

- 3" Poplar N74°W, 6.53'
- 4" Poplar N4°W, 9.31'
- 4" Spruce N78°E, 19.11'
- 5" White Birch S62°W, 41.54'

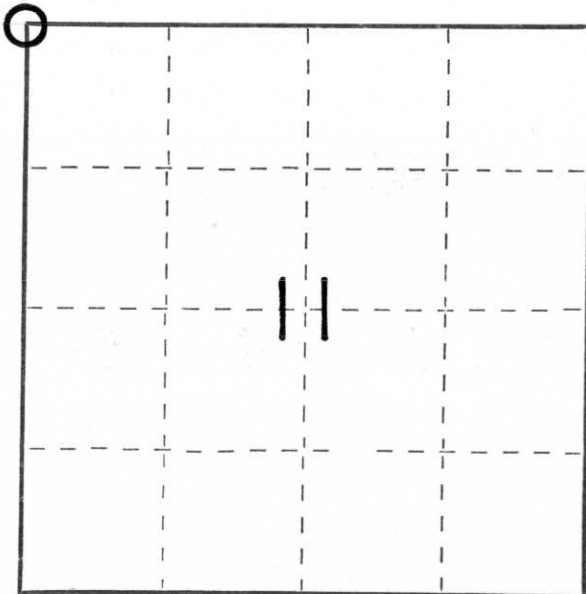

○ = Corner monument restored.

Dated at Merrill, Wis., this 20th day of April, 1978.

Signature Sheridan D. Schwark Title Registered Land Surveyor Registration No. S-1205
(County Surveyor, Registered Land Surveyor, or other duly authorized official)

Office of Register of Deeds, County of _____, I hereby certify that the within instrument was filed in this office for record on the _____ day of _____, 19____ at _____ o'clock _____ M.

.....
(Register of Deeds)

By _____ Deputy









