

CERTIFIED LAND CORNER RESTORATION

Index No. E-19

State of Wisconsin }  
County of Lincoln } ss.

History of original corner establishment:

NOTES NOT AVAILABLE.

I Sheridan D. Schwark, do hereby certify that on the 18th day of April, 1978, I found evidence of the North one-quarter corner of Section 11 Township 32, North, Range 5 East, Fourth, Principal Meridian, as described hereon; and that from this evidence I established a new monument and accessories as described hereon to perpetuate the original location of this corner.

Description of corner evidence found:


We dug the intersection of Burma Road and the private road to the East and West to a depth lower than the natural grade and also off the roadway at an old fence corner and found nothing. We reset the corner on line halfway between the Northeast and the Northwest section corners. The corner fit the traveled portion of Burma Road reasonably well.

Resident witnesses:

.....  
.....  
.....

Description of monument and accessories I established to perpetuate the original location of this corner.

We set a Lincoln County Berntsen monument with the following witness monuments:  
1" x 30" iron pipe set 6" from 4" Poplar, blazed and painted red bearing N56°W, 66.88'  
1" x 30" iron pipe set on same bearing as power pole, bearing N26°E, 42.25'  
1" x 30" iron pipe set 7" from 6" Poplar, blazed and painted red bearing S60°E, 56.06'  
1" x 30" iron pipe set 7" from Power pole No. 3205-11W9 bearing, S26°W, 77.19'

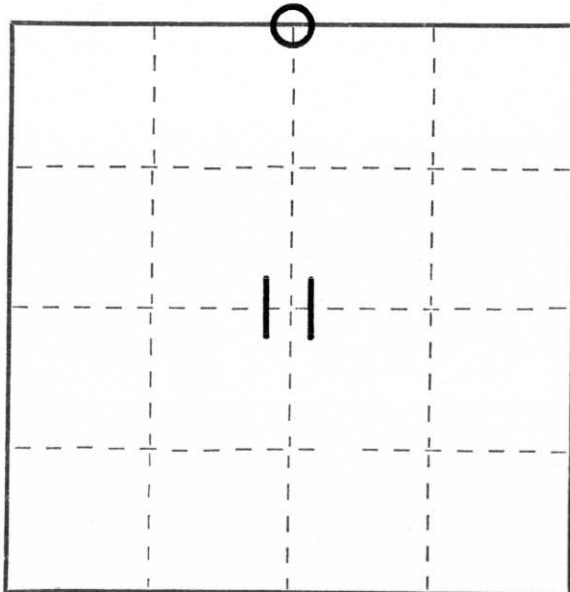

○ = Corner monument restored.

Dated at Merrill, Wis., this 20th day of April, 1978.

Signature Sheridan D. Schwark Title Registered Land Surveyor Registration No. S-1205  
(County Surveyor, Registered Land Surveyor, or other duly authorized official)

Office of Register of Deeds, County of \_\_\_\_\_, I hereby certify that the within instrument was filed in this office for record on the \_\_\_\_\_ day of \_\_\_\_\_, 19\_\_\_\_ at \_\_\_\_\_ o'clock \_\_\_\_\_ M.

.....  
(Register of Deeds)

By \_\_\_\_\_ Deputy





















N4540