



MINK CAPITAL SURVEYING, INC.
SURVEY MONUMENT LOCATION RECORD

LANDMARK BENCHMARK

CORNER IDENTITY W 1/4 COR ON S. LINE
 DATE OF SURVEY AUG 4, 1975
 WEATHER CLEAR CALM
 TEMPERATURE 85°
 SURVEY PARTY D. TLUSTY M. HENRICHS

FOUND
 SET
 RE-SET
 RE-TIED

SECTION 24
 TOWNSHIP 32 N
 RANGE 5E
HARDING LINCOLN
 CO.

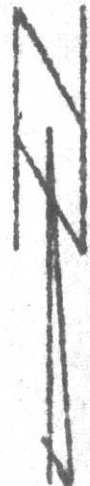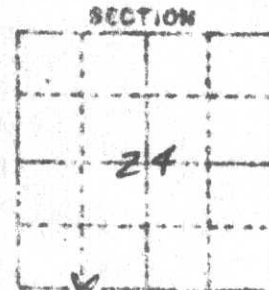


REASONS FOR MONUMENT LOCATION
 METHOD OF SURVEY AND CORNER AUTHENTICATION

SEE SURVEY FOR PAUL REINHART

SKETCH SHOW HORIZONTAL TIE DISTANCES TO FIXED WITNESS MONUMENTS. DESCRIBE ALL MONUMENTS FOUND OR SET.

*1 3/4" I.P.
 TOP 1.7' OUT OF GROUND
 TIPPED SOUTH
 WOOD BASE*

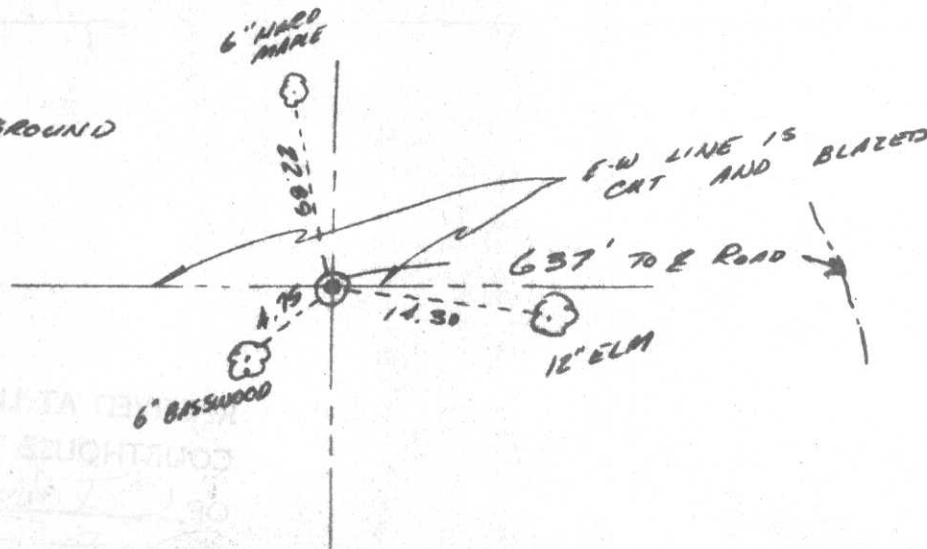

YOUNG MICHIGAN TA...
 COUNTY...
 OFFICE

Q-22


MINK CAPITAL SURVEYING, INC.
SURVEY MONUMENT LOCATION RECORD

LANDMARK BENCHMARK

FOUND
 SET
 RE-SET

SECTION 24
 TOWNSHIP 32
 RANGE 5E
Lincoln County


CORNER IDENTITY W/4 ON S. Line 24-32.5E
 DATE OF SURVEY AUG. 9, 1975
 WEATHER _____
 TEMPERATURE 85°
 SURVEY PARTY D.T. & D.M.

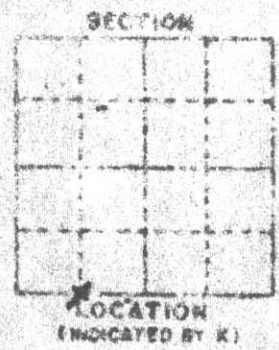

BASIS FOR MONUMENT LOCATION
 DESCRIBE METHOD OF SURVEY AND CORNER AUTHENTICATION

*FOUND 1 3/4 I.P.; 1.7 ABOVE GROUND. TIPPED South.
 USED BRASS
 SEE SURVEY FOR PAUL REINHART.*

FIELD SKETCH SHOW HORIZONTAL DISTANCES TO FIXED WITNESS MONUMENTS. DESCRIBE ALL MONUMENTS FOUND OR SET

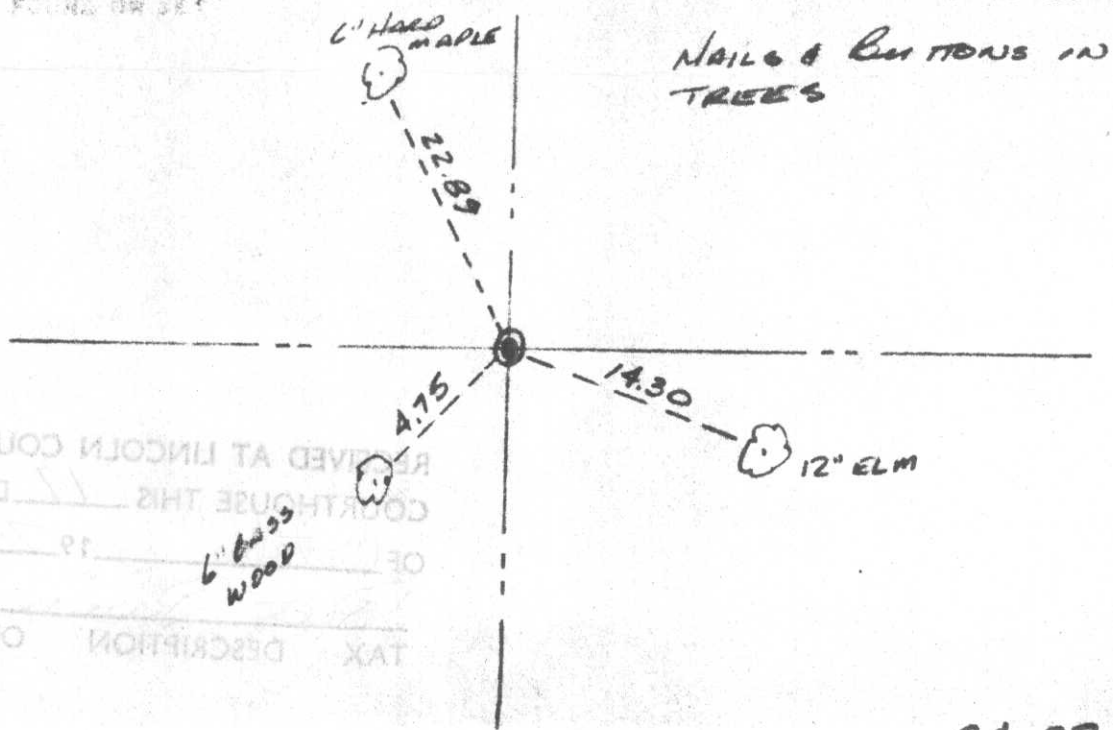

TAX DESCRIPTION OFFICE _____
 OF _____ DAY _____
 ARRIVED AT LINCOLN COUNTY COURTHOUSE THIS _____ DAY _____

24-32-5E

Q-22