

CERTIFIED LAND CORNER RESTORATION


Index No. Q-1

State of Wisconsin }
County of Lincoln } ss.

I Sheridan D. Schwark, do hereby certify that on the 10th day of May, 1977, I found evidence of the Northwest corner of Section 30 Township 32, North, Range 6 East, Fourth, Principal Meridian, as described hereon; and that from this evidence I established a new monument and accessories as described hereon to perpetuate the original location of this corner.

Resident witnesses:

.....
.....
.....

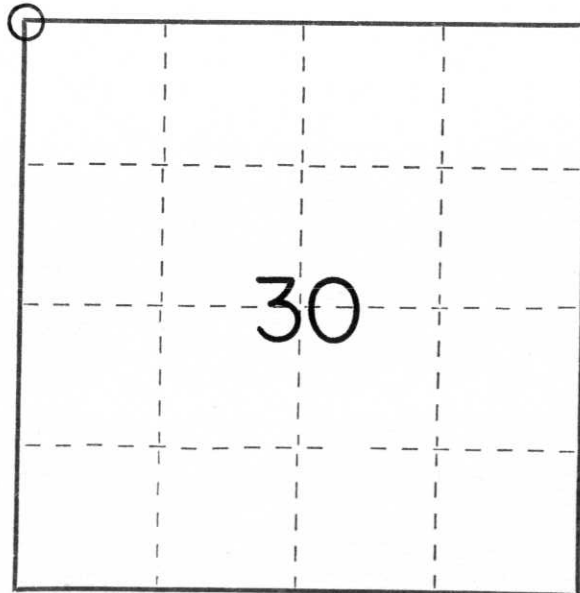

○ = Corner monument restored.

History of original corner establishment:

Date: July & August, 1851
Surveyor: James M. Marsh
Monument: Wood Post
Witnesses: 10" Birch, S81°E, 32 links
14" Hemlock, S71°W, 32 links
12" Hemlock, N36°W, 17 links
12" Birch, N31°E, 28 links

Description of corner evidence found:

6" x 6" stone monument found approximately 2' North of road centerline, 2.5' below grade. We set a 3/4" solid iron rod over the stone.

Description of monument and accessories I established to perpetuate the original location of this corner.

We set the following witness monuments to the stone monument:

- P.K. in power pole No. 3206-30W12, Southeast 40.9'
- P.K. in 12" White Birch, South 43.0'
- 3/4" x 30" solid iron rod set, North 14.8'
- P.K. in fence post, Northwest, 26.3'

Dated at Merrill, Wis., this 23rd day of June, 1978

Signature Sheridan D. Schwark Title Registered Land Surveyor Registration No. S-1205
(County Surveyor, Registered Land Surveyor, or other duly authorized official)

Office of Register of Deeds, County of _____, I hereby certify that the within instrument was filed in this office for record on the _____ day of _____, 19____ at _____ o'clock _____ M.

.....
(Register of Deeds)

By _____ Deputy



2002 7 18



2002 7 18



LINCOLN COUNTY
SHERIFFS OFFICE

2002 7 18