

U.S. PUBLIC LAND SURVEY MONUMENT RECORD


Note: This form is intended and designed to fulfill all requirements of Wisconsin Administrative Code, Chapter A-E 5.02, U.S. Public Land Survey Monument Record (3) (a) (b) (c) (d) (e) (f) (g) (h) (i). An additional sheet may be added if necessary to conform with said requirements.

(a) Corner location: Township 32 North

Range 5 East

Town/City/Village HARDING

County LINCOLN

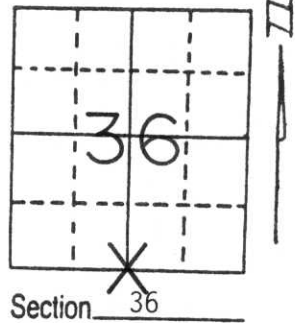


Section 36

(b) (f) (g) (h) Description of monument found at this corner and if it was accepted, state all evidence (material, testimonial, occupational, plats, records, other monuments) used as a basis for accepting. If not accepted or if nothing was found, state evidence used as basis for establishing location. If reestablished through lost corner proportionate methods, indicate all monuments, distances and directions used to establish.

Talked with local land owner, Brosowski, he said there was a Iron Bar at fence intersection that every one called the property corner. Traversed to area, found old fence lines, laying down, found old corner fence post, found existing 1/2" Iron Bar with ribbon on it. Removed Bar, set Lincoln County Monument, tied out. Section break down of South line Section 36 enforced location as good. Held as corner. Painted all witness bars yellow. Set steel post with yellow warning sign by monument.

SEE BACK FOR SECTION BREAK DOWN

(c) (d) (e) Plan view of corner with ties to at least 4 witness monuments. If in disagreement with previously established corner, show the distances between the two corners and also indicate the ties to the disputed corner.

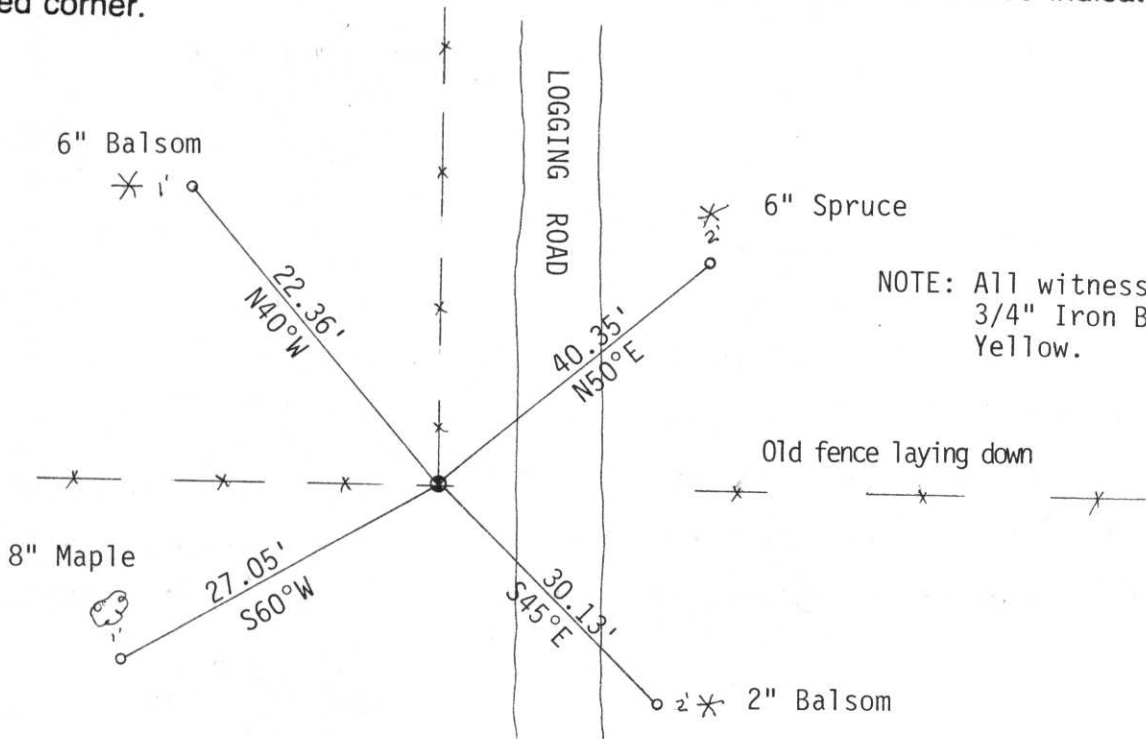

(i) I, David L. Osterbrink RLS No. S-2014

(type or print name) certify that the corner location on this record was determined by me or under my direction and control and that this U.S. Public Land Survey Monument Record is correct and complete to the best of my knowledge and belief.

David L. Osterbrink

12-15-92

Signature


Date



Index No. 4-23


HARDING
CITY VILLAGE TOWN

NOTE: USE REVERSE SIDE FOR EXPLANATORY REMARKS & SKETCHES.

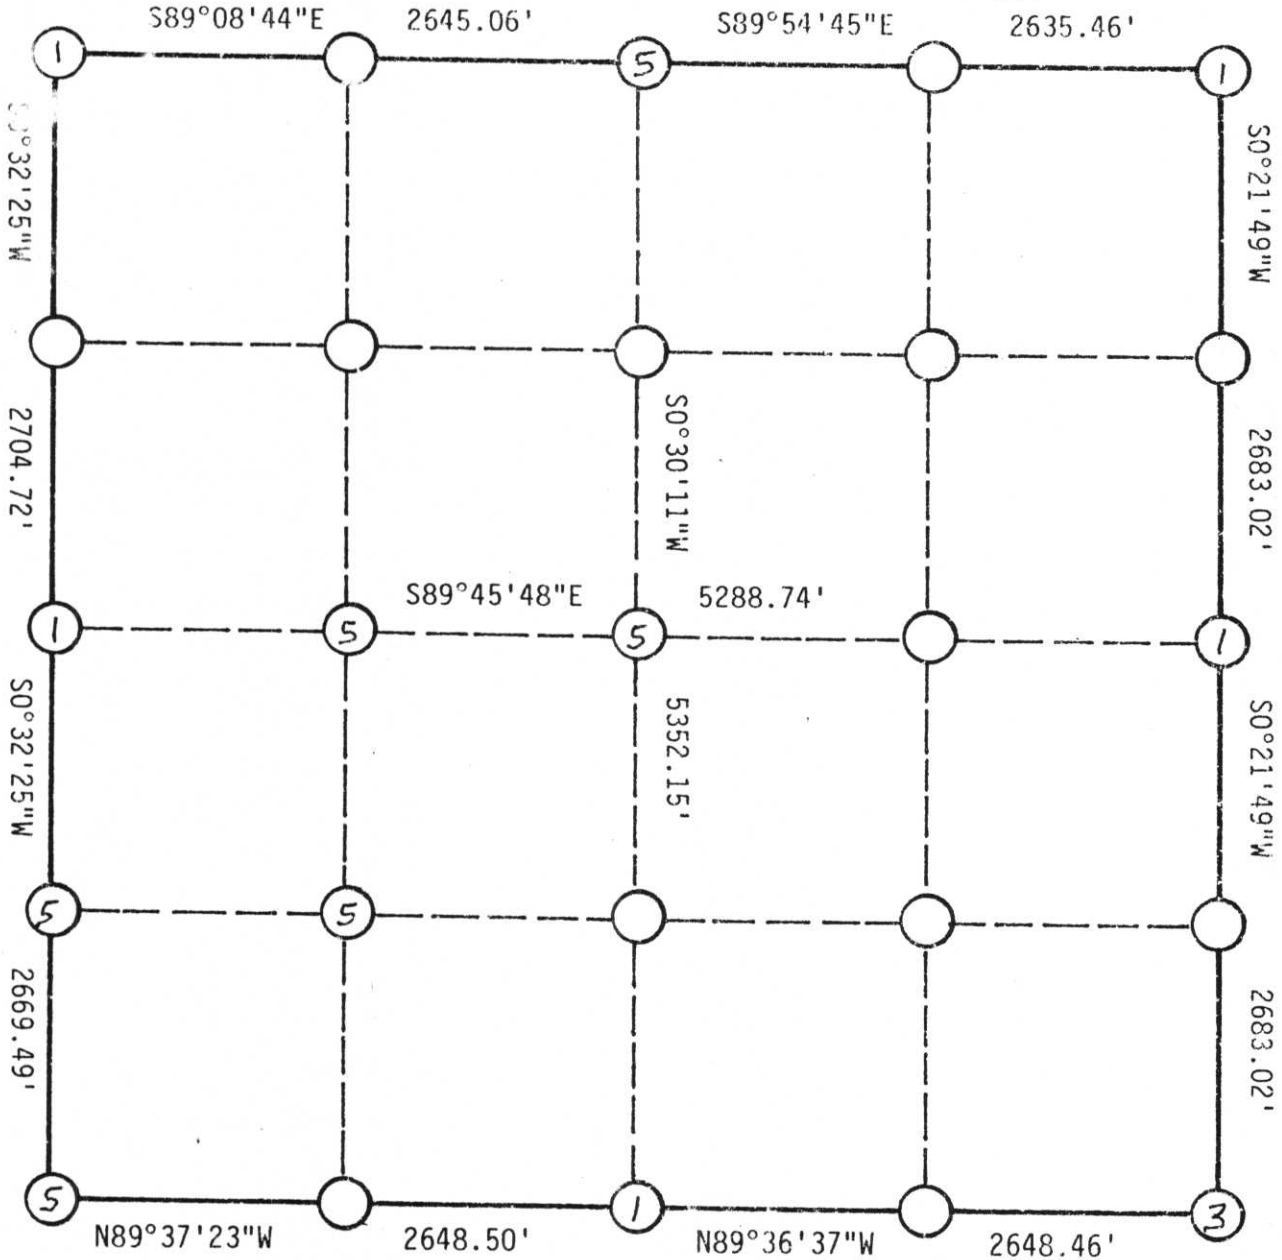

MONUMENT LEGEND : (Specify material and size)

- ① CAST METAL Lincoln County Aluminum Monument
- ② CONCRETE _____
- ③ STONE Granite
- ④ IRON ROD/BAR _____
- ⑤ IRON PIPE 2"
- ⑥ SPIKE / NAIL _____
- ⑦ OTHER _____

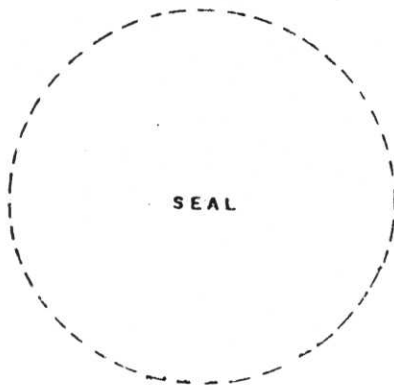

SIGNED: _____

DATE: _____

RECEIVED AT LINCOLN COUNTY
COURTHOUSE THIS 2nd DAY
OF Dec. 1992
Pat Priebe
TAX DESCRIPTION OFFICE