


CERTIFIED LAND CORNER RESTORATION

Index No. 45 I-25

State of Wisconsin }
County of Lincoln } ss.

I Sheridan D. Schwark, do hereby
certify that on the 27th day
of November 1977, I found
evidence of the northeast
corner of Section 13
Township 32, North, Range
6 East, Fourth, Principal Meridian,
as described hereon; and that from this evidence
I established a new monument and accessories
as described hereon to perpetuate the original
location of this corner.

Resident witnesses:

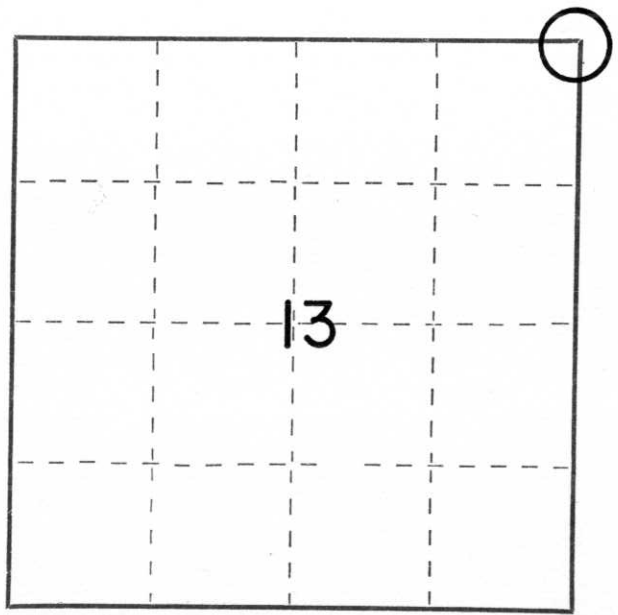

○ = Corner monument restored.

History of original corner establishment:
Date: July, 1881
Surveyor: James Marsh
Monument: Wood post
Witnesses: 11" hemlock, S4°E, 50 links
16" " S30°W, 10 links
16" " N59°W, 20 links
8" " N31°E, 12 links

Description of corner evidence found:
We dug to a depth which was lower than the original grade and had no success. We were also unable to find remains of any of the original bearing trees. The centerline of Lincoln Drive and fencelines fit original distances reasonably well; therefore we accepted them as best available evidence to re-establish the corner.

Description of monument and accessories I established to perpetuate the original location of this corner.
Set a Lincoln County Berntsen Monument with the following witness monuments:
3/4" x 30" round iron rod, + 2' north of the edge of the bituminous roadway, N75°W, 52.00'
" " " " , " south " " " " " " " " " " S75°W, 51.57'
" " " " , ± 1' W of a 4" spruce, S70°E, 58.01'
" " " " , ± 1' S of a 6" red pine, N12°E, 38.58'

Dated at MERRILL, Wis., this 28th day of NOVEMBER, 1977.

Signature Sheridan D. Schwark Title Registered Land Surveyor Registration No. S-1205
(County Surveyor, Registered Land Surveyor, or other duly authorized official)

Office of Register of Deeds, County of Lincoln, I hereby certify that the within
instrument was filed in this office for record on the _____ day of _____, 19____
at _____ o'clock _____ M.

(Register of Deeds)

By _____ Deputy