
U.S. P	UBLIC LAND S	SURVEY M	ОИИМЕНТ	RECORD
Public Land Survicently said (a) Corner location:	nded and designed to fulfill all rey Monument Record (3) (a) (id requirements. Township 32 Nor	(D): (B) (I) (g) (h	sconsin Administrative) (i). An additional she	et may be ded if necessary to
(=) comor localion,		าเก		
	Range 6 East			1701
TownMerri	11			13/21
CountyLinco	În ·		20 25	
b) (f) (-) (f) D				Bectlon
not accepted or	if nothing was found, rough lost corner proper	state evidence	nonuments) used a	epted, state all evidence as a basis for accepting. If r establishing location. If onuments, distances and
Wisconsin F line of the East $\frac{1}{4}$ Corn	area, found no evidence corner was area so River Lots Plat, we folk SE $\frac{1}{4}$. Distances chemer. Measured to NW Coroner. SE Cor. as established	ound existing in the core core core core core core core cor	rons monumenting irons, and use	Swansons g the East d to set
				×
		*		
disputed corner.	0	P.	10" Cedar	greement with previously bindicate the ties to the
X	× × × ×	× ××	N59 °50 '38"E	12" Cedar
		27.47	, , , , , , , , , , , , , , , , , , ,	
Note: All tr	ees blazed with 20 Pe	3	Sir.	
spike	;.	enny 57	14" Cedar	
4.4		1320	. Octua	e
		2		. 1
		į		
i) I,		40 Corn	er from Swansons	s Wisconsin River
(type or print name was determined by this U.S. Public L	e) certify that the corner y me or under my direction and Survey Monument est of my knowledge an	location on this re on and control and Record is correct d belief.	Lots Placecord dithat	
Signature	mendrach	2-6-9	O ABE	NDROTH \$ 9
angrialul B		Date	€ 7.4 €	S-798
				WIS.
			2000	TO VE TOBS
			00000	200000000000000000000000000000000000000



RECEIVED AT LINCOLN COUNTY
CO HOUSE THIS 20th DAY
C 7et 19 90

TAX Priebe



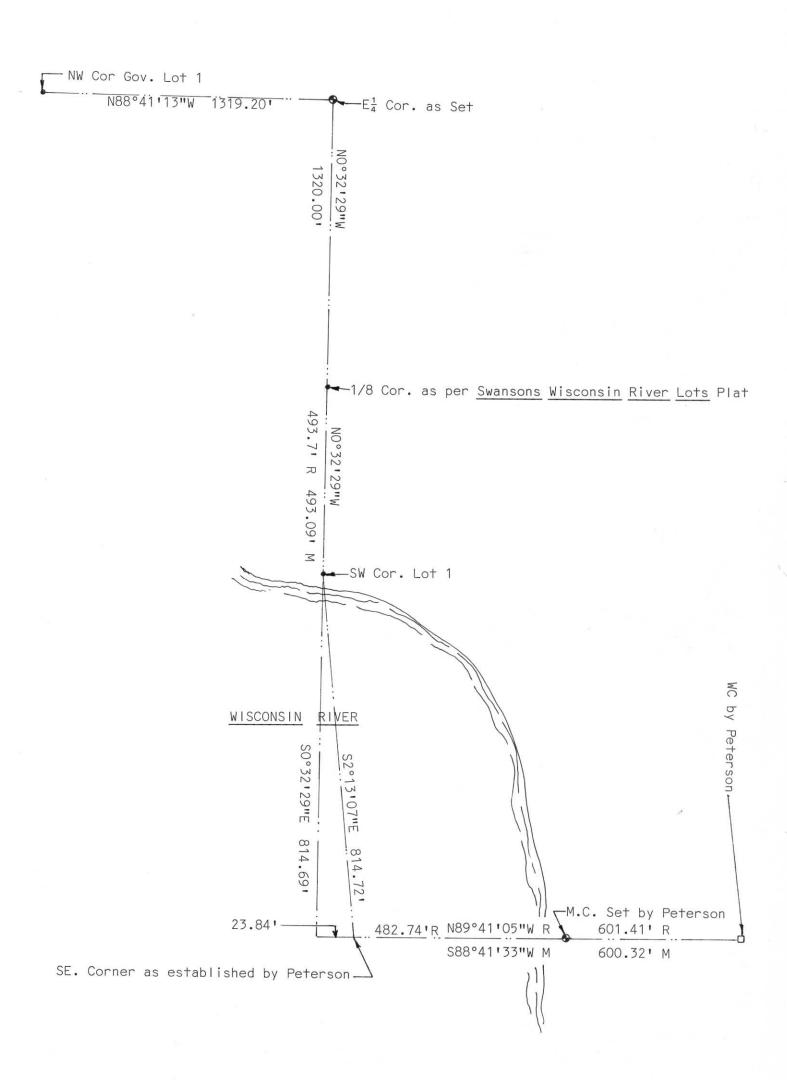





