

CERTIFIED LAND CORNER RESTORATION

Index No. A-9, 10

State of Wisconsin }
 County of } ss.

History of original corner establishment:

I....., do hereby certify that on the.....day of....., 19....., I found evidence of the.....corner of.....Township.....31....., North, Range.....6....., Fourth, Principal Meridian, as described hereon; and that from this evidence I established a new monument and accessories as described hereon to perpetuate the original location of this corner.


Description of corner evidence found:

ORIGINAL CORNER OBLITERATED DUE TO THE CONSTRUCTION OF ALEXANDER DAM AND THE FLOODING OF THE LAND BY THE WATER OF THE RESERVOIR


Resident witnesses:

.....

Description of monument and accessories I established to perpetuate the ~~original~~ location of this corner.
 SET LINCOLN COUNTY BERNTSEN MONUMENT

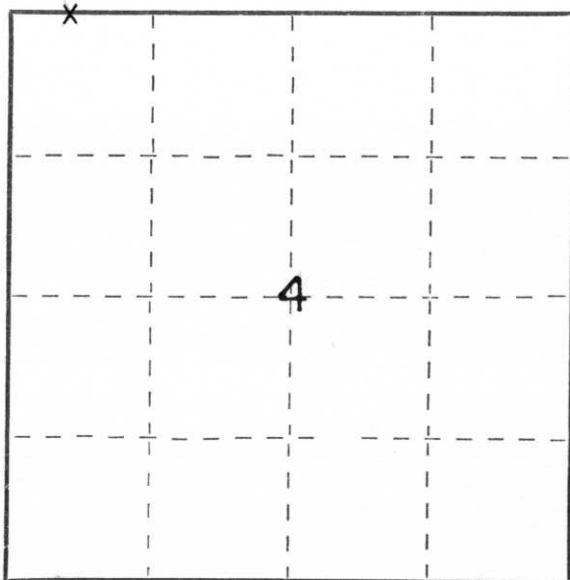

○ = Corner monument restored.

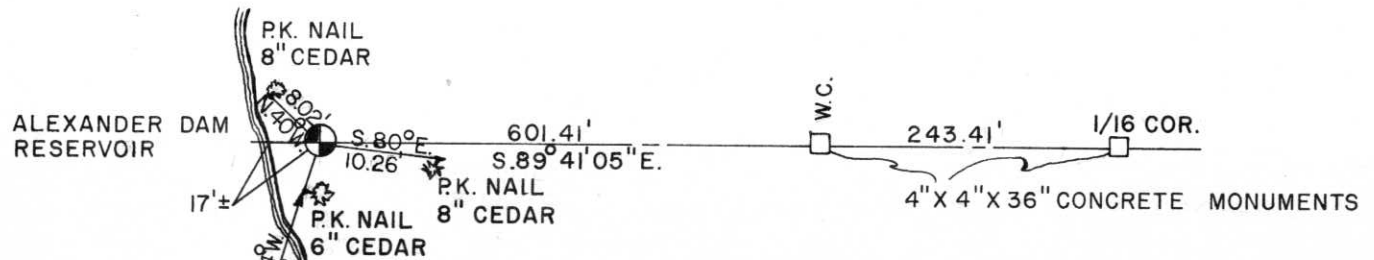

Dated at Gran Bay, Wis., this 9th day of July, 1981

Signature Elton O. Peterson Title Reg. Land Surveyor Registration No. S-1304
 (County Surveyor, Registered Land Surveyor, or other duly authorized official)

Office of Register of Deeds, County of....., I hereby certify that the within instrument was filed in this office for record on the.....day of....., 19..... at.....o'clock..... M.

.....
 (Register of Deeds)

By.....Deputy



25 4:16 PM

PLANNED
PROTECT
NEARBY
SURVEY
MARKER
MAY 2000 100

25 4:17 PM





www.fox.com